FILED
GREENVILLE CO. S.C.
FEB 5 11 39 AM '81
DONNIE S. TANKERSLEY
R.M.C.

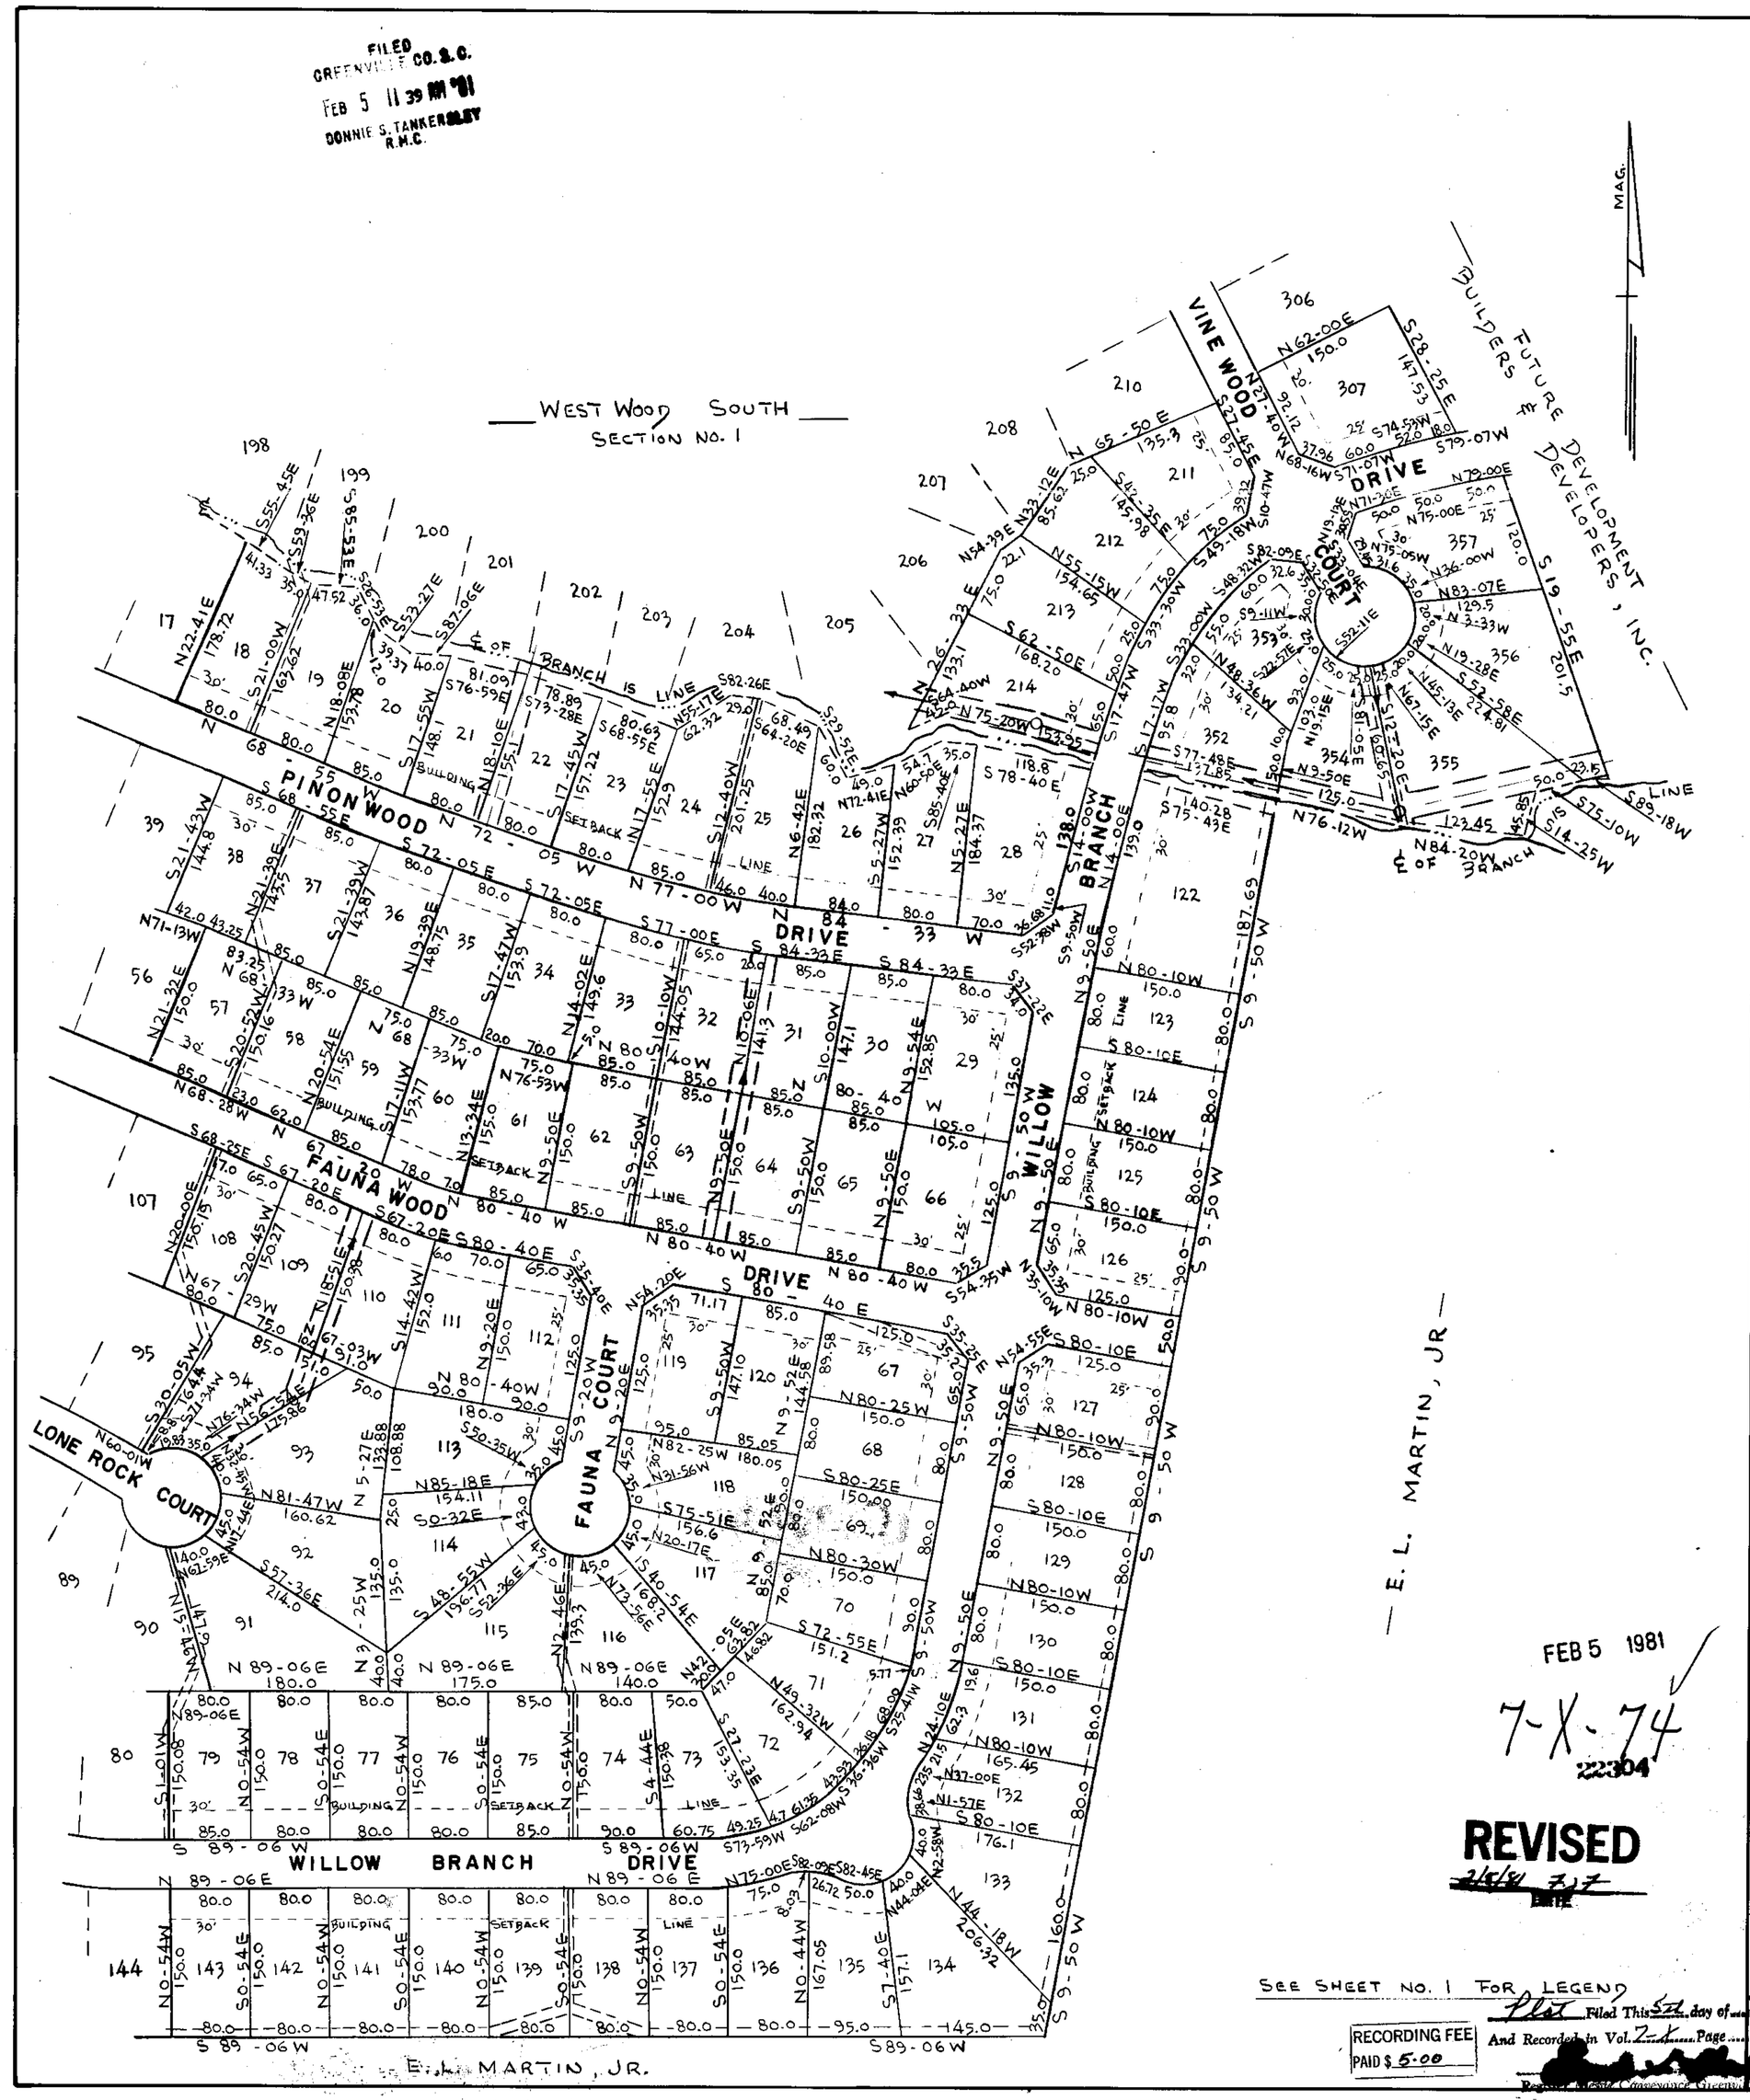

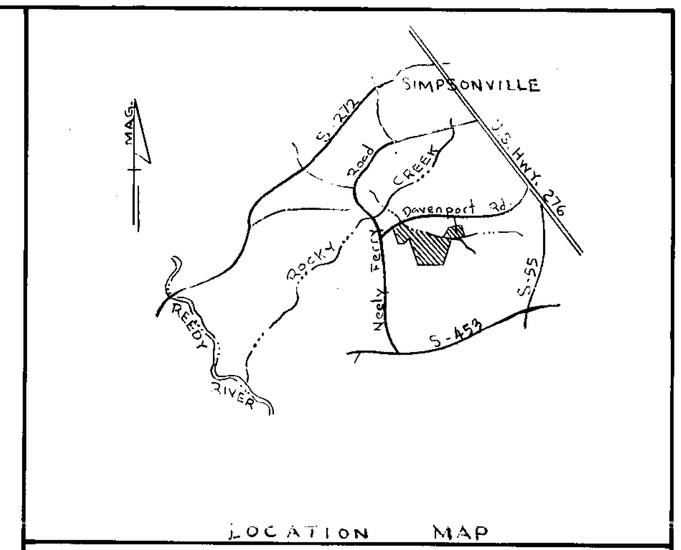

LOCATION MAP

FINAL PLAT

CERTIFICATE OF OWNERSHIP AND DEDICATION

"The undersigned hereby acknowledge that I am (we are) the owner(s) of the property shown and described hereon and that I (we) hereby adopt this plan of subdivision with my (our) free consent and that I (we) establish the minimum building restriction lines, and hereby dedicate to public use as roads, streets, and easements, forever all areas so shown or indicated on said plat.

___ / ___ / ___ Signed _____

___ / ___ / ___ Signed _____

___ / ___ / ___ Signed _____

___ / ___ / ___ Signed _____

CERTIFICATE OF ACCURACY

"I, James D. Crain, certify that this plat was (drawn by me) (drawn under my supervision) (an actual survey made under my supervision) from (an actual survey made by me) (deed description recorded in Book 1067, Page 512, Book _____, Page _____, etc.) (other); that the error of closure as calculated by latitudes and departures is 1/3000+, that the boundaries not surveyed are shown as broken lines plotted from information found in Book _____, Page _____; that this plat was prepared in accordance with the Greenville County Subdivision Regulations as adopted.

9-17-79 — DATE

James D. Crain — LICENSED ENGINEER OR REGISTERED SURVEYOR

S. C. Registration No. 3320

CERTIFICATE OF APPROVAL FOR RECORDING

"I hereby certify that the subdivision plat shown hereon has been found to comply with the Subdivision Regulations for Greenville County, with the exception of such variances, if any, as are noted in the minutes of the Greenville County Planning Commission of Greenville County, South Carolina, and that it has been approved for recording in the office of the County Register of Mense Conveyance."

9/27/79 — DATE

[signature] — DIRECTOR OF PLANNING, GREENVILLE COUNTY PLANNING COMMISSION

FILE NUMBER
79-165

WESTWOOD SOUTH
SECTION NO. 2
SHEET NO. 2

BUILDERS & DEVELOPERS, INC. — OWNER

PIEDMONT SURVEYORS — SURVEYOR

NO. OF ACRES: SEE SHEET NO. 1

MILES SEE SHEET NO. 1

NO. OF LOTS: SEE SHEET NO. 1

DATE: JUNE 19, 1979
SAN. SEWER RIW ADDED LOTS NO. 21, 22, 355 & 356
10-30-80

SCALE: 1" = 100'

100 50 0 100 200 300

FEB 5 1981

7-X-74

22304

REVISED

2/5/81 7.7
DATE

SEE SHEET NO. 1 FOR LEGEND

Plat Filed This 5th day of Feb 1981
And Recorded in Vol. 7-X Page 74 at 11:39 AM

RECORDING FEE PAID $ 5.00

[redacted]

10703