


FILED CO. 8. C.  
 FEB 5 11 39 AM '81  
 R.A.C.

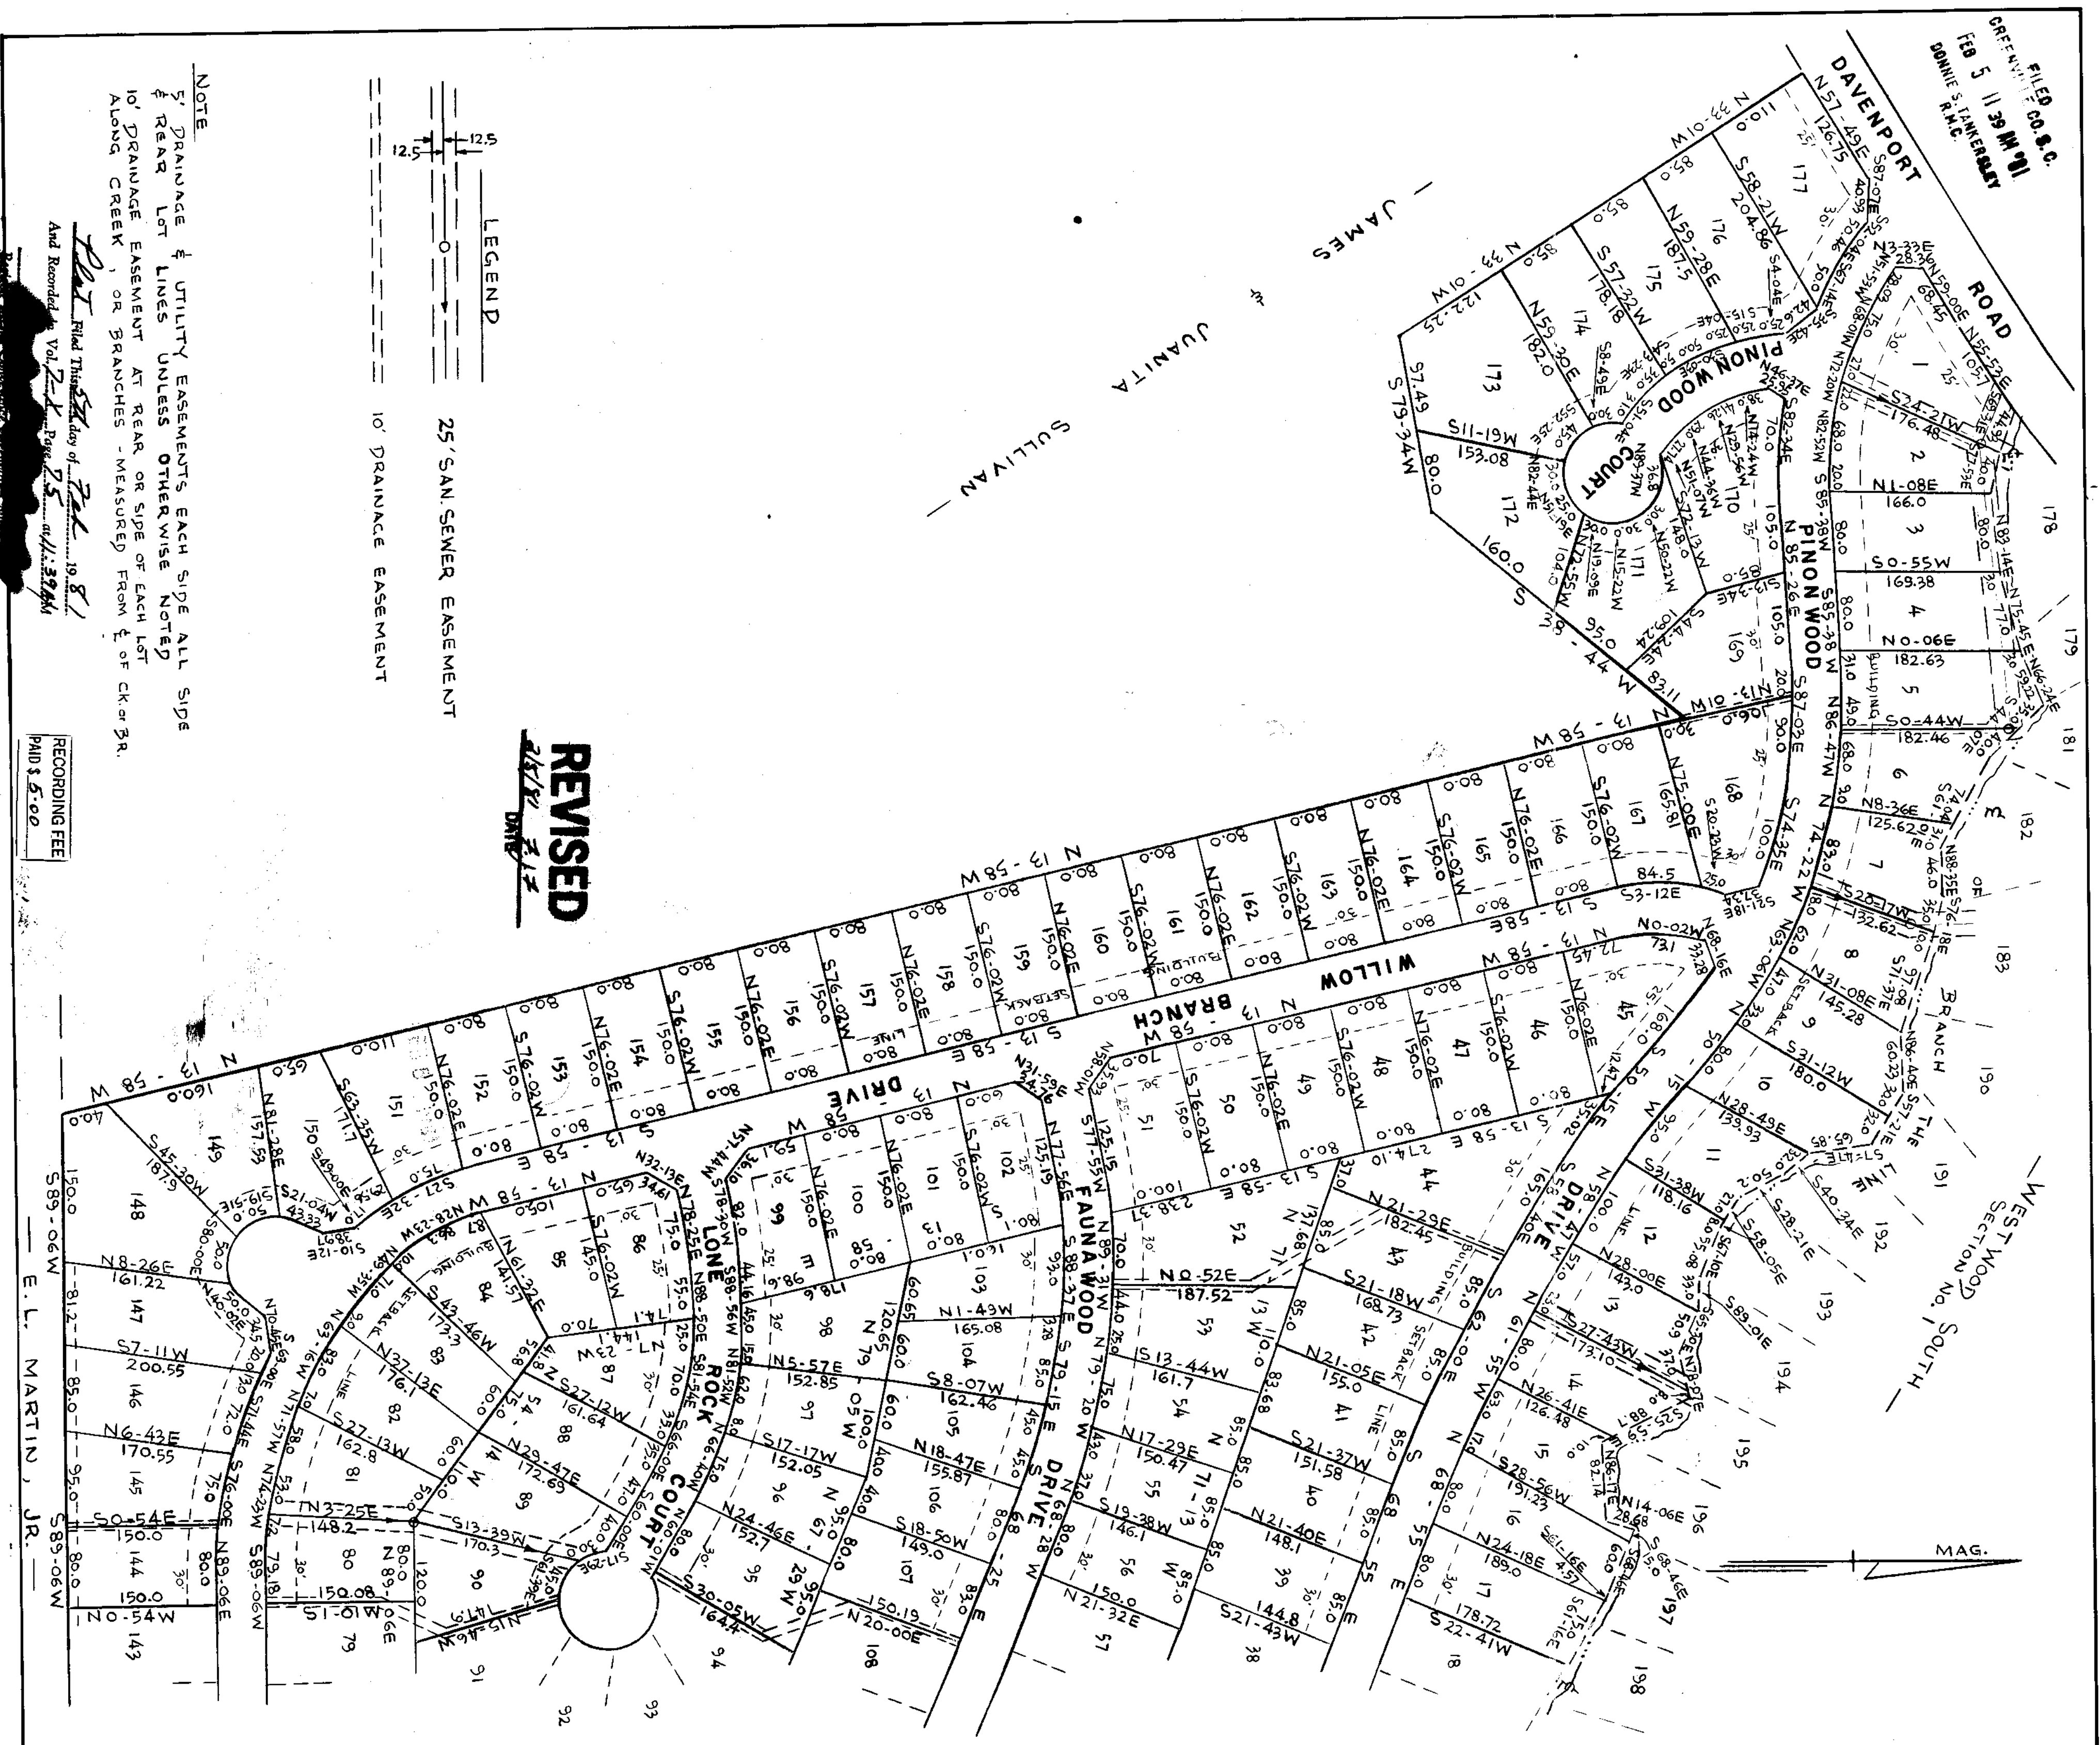


**REVISED**  
 2/17/79  
 D.M.V.

**NOTE**  
 5' DRAINAGE & UTILITY EASEMENTS, EACH SIDE ALL SIDE & REAR LOT LINES UNLESS OTHERWISE NOTED  
 10' DRAINAGE EASEMENT AT REAR OR SIDE OF EACH LOT ALONG CREEK OR BRANCHES - MEASURED FROM E. OF CLEAR BR.

Plat Filed This Day of Feb 19 81  
 And Recorded in Vol. 2-K Page 75 of 11-3-81

RECORDING FEE  
 PAID \$ 5.00

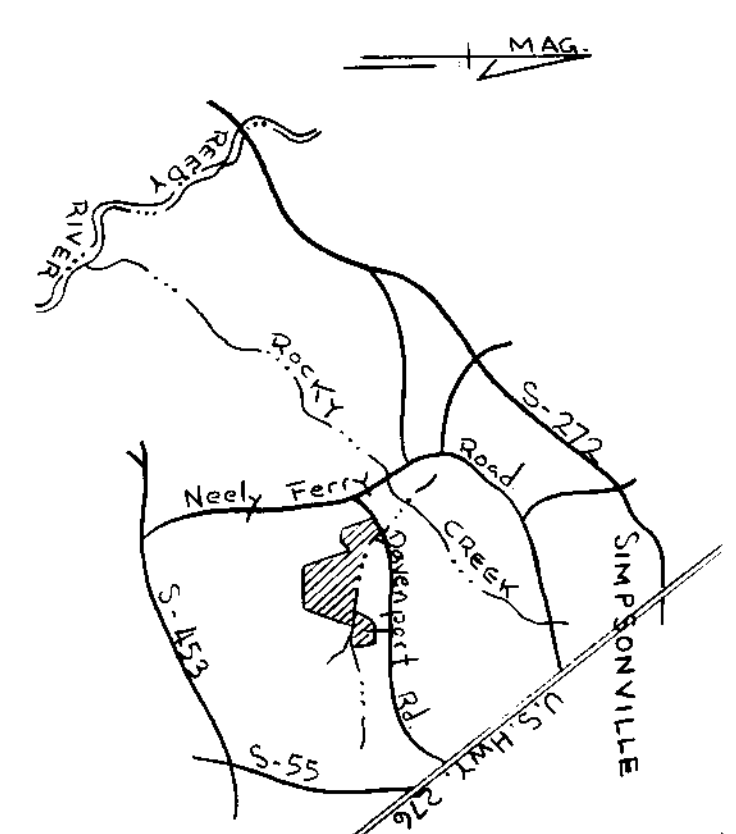

**FINAL PLAT**

**CERTIFICATE OF OWNERSHIP AND DEDICATION**  
 "The undersigned hereby acknowledge that I am (we are) the owner(s) of the property shown and described hereon and that I (we) hereby adopt this plan of subdivision with my (our) free consent and that I (we) establish the minimum building restriction lines, and hereby dedicate to public use as roads, streets, and easements, forever, all areas so shown or indicated on said plat:


**CERTIFICATE OF ACCURACY**

"I, James D. Galloway, certify that this plat was (drawn by me) (drawn under my supervision) (an actual survey made under my supervision) from an actual survey made by me) (said description recorded in Book 267 Page 572 Book 100 (sic) (other); that the error of closure as calculated by latitudes and departures is 0.00 feet; that the boundaries not surveyed are shown as broken lines plotted from information found in Book 100 Page 572; that this plat was prepared in accordance with the Greenville County Subdivision Regulations as adopted.

DATE 9-17-79  
James D. Galloway  
 LICENSED ENGINEER OR REGISTERED SURVEYOR

S. C. Registration No. 3330

**CERTIFICATE OF APPROVAL FOR RECORDING**

"I hereby certify that the subdivision plat shown hereon has been found to comply with the Subdivision Regulations for Greenville County, with the exception of such variance, if any, as are noted in the minutes of the Greenville County Planning Commission of Greenville County, South Carolina, and that it has been approved for recording in the office of the County Register of Deeds Conveyance."

DATE 9/22/79  
Gregory G. Galloway  
 DIRECTOR OF PLANNING  
 GREENVILLE COUNTY PLANNING COMMISSION

7-X-75 22304  
 FEB 5 1981  
**FILE NUMBER**  
**79-165**

WESTWOOD SOUTH  
 SECTION NO. 2  
 SHEET NO. 1

PULLDERS & DEVELOPERS, INC. OWNER  
 PIEDMONT SURVEYORS SURVEYOR

NO. OF ACRES: **70.69** MILES **1.6**

NO. OF LOTS: **187**  
 DATE: JUNE 19, 1979  
 SAN SEWER RIV. REVISED  
 LOTS AND 13, 9, 7, 5, 8

