


FILED  
 GREENVILLE COUNTY, S. C.  
 MAR 23 3 14 PM '81  
 DONNIE S. TAMERSLEY  
 H.M.C.

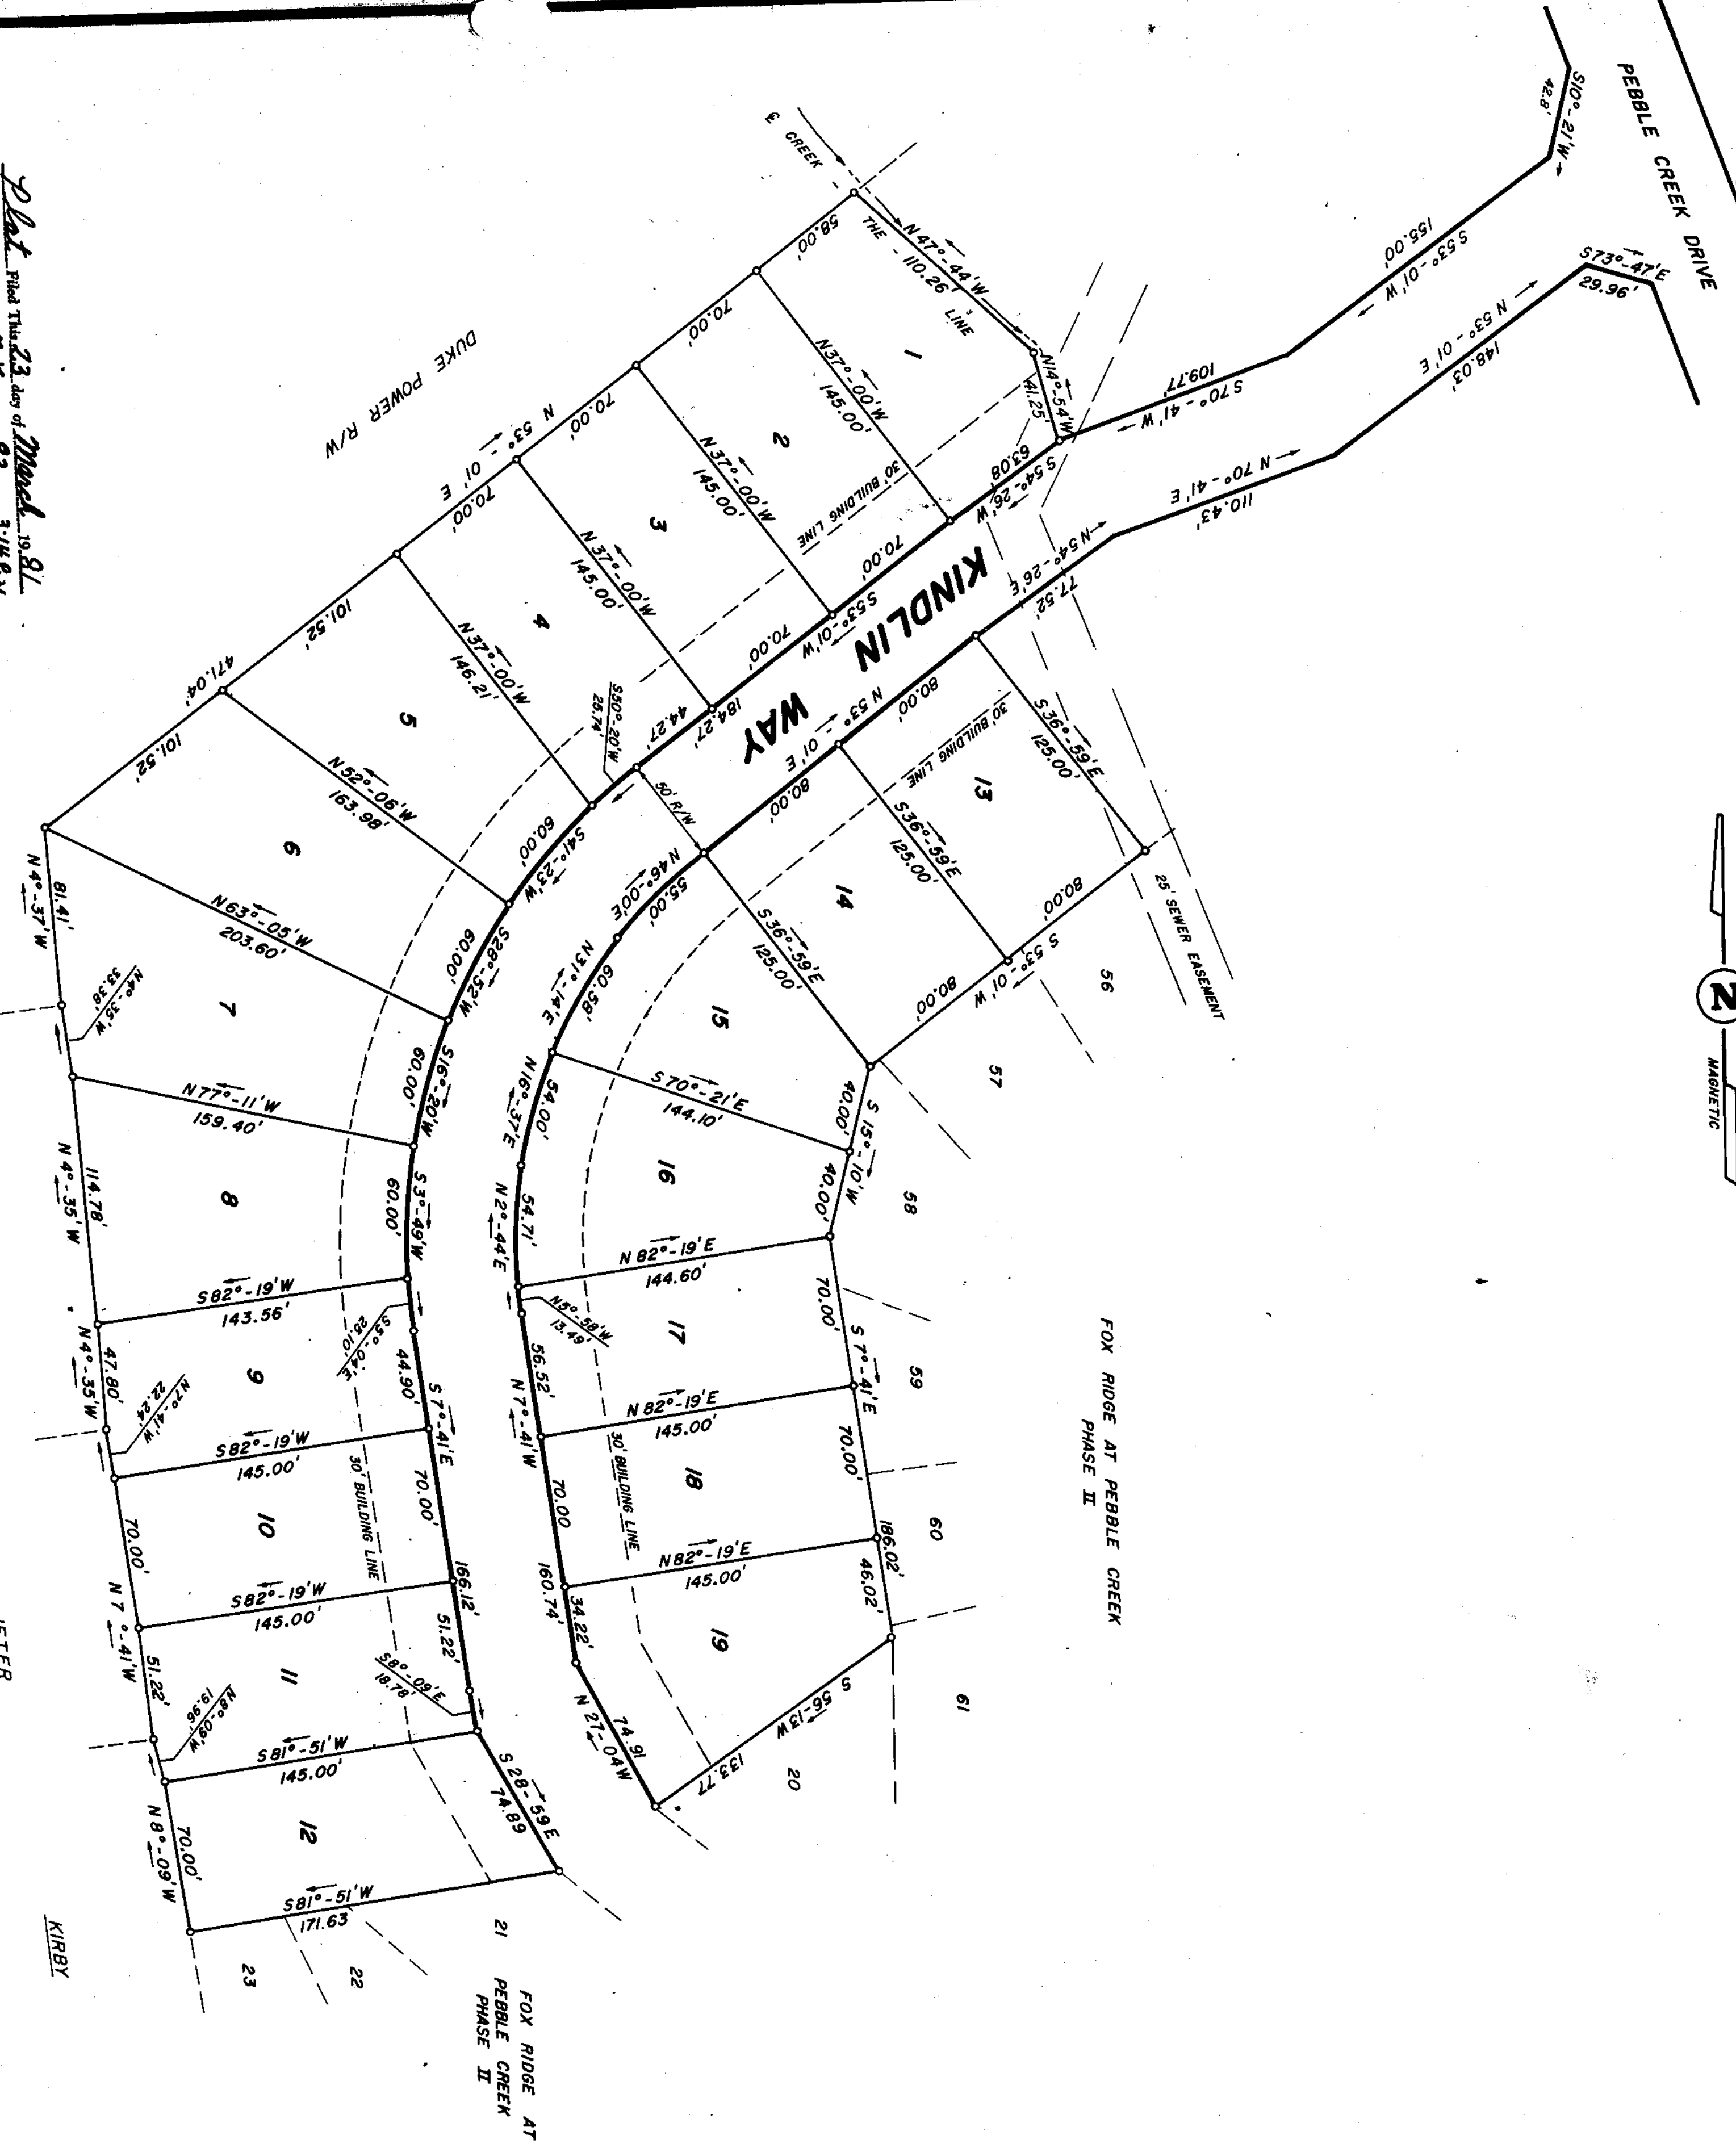


**NOTES**  
 1. 5' DRAINAGE AND UTILITY EASEMENT  
 ALONG EACH SIDE OF ALL SIDE AND  
 REAR LOT LINES.  
 2. IRON PINS AT ALL CORNERS.



Plot filed this 23 day of March 1981  
 And Recorded in Vol. 78-143  
 Register Name Conveyance Greenville County, S. C.

RECORDING FEE  
 PAID \$ 5.00

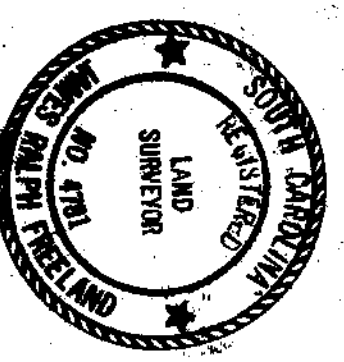

REVISED LOT 1-7/6/79

REVISED LOT 12-8/19 MARCH 23, 81

78-143  
 25594-A


REVISED  
 3/23/81

DUKE POWER CO.

JETER

KIRBY

FOX RIDGE AT  
 PEBBLE CREEK  
 PHASE II

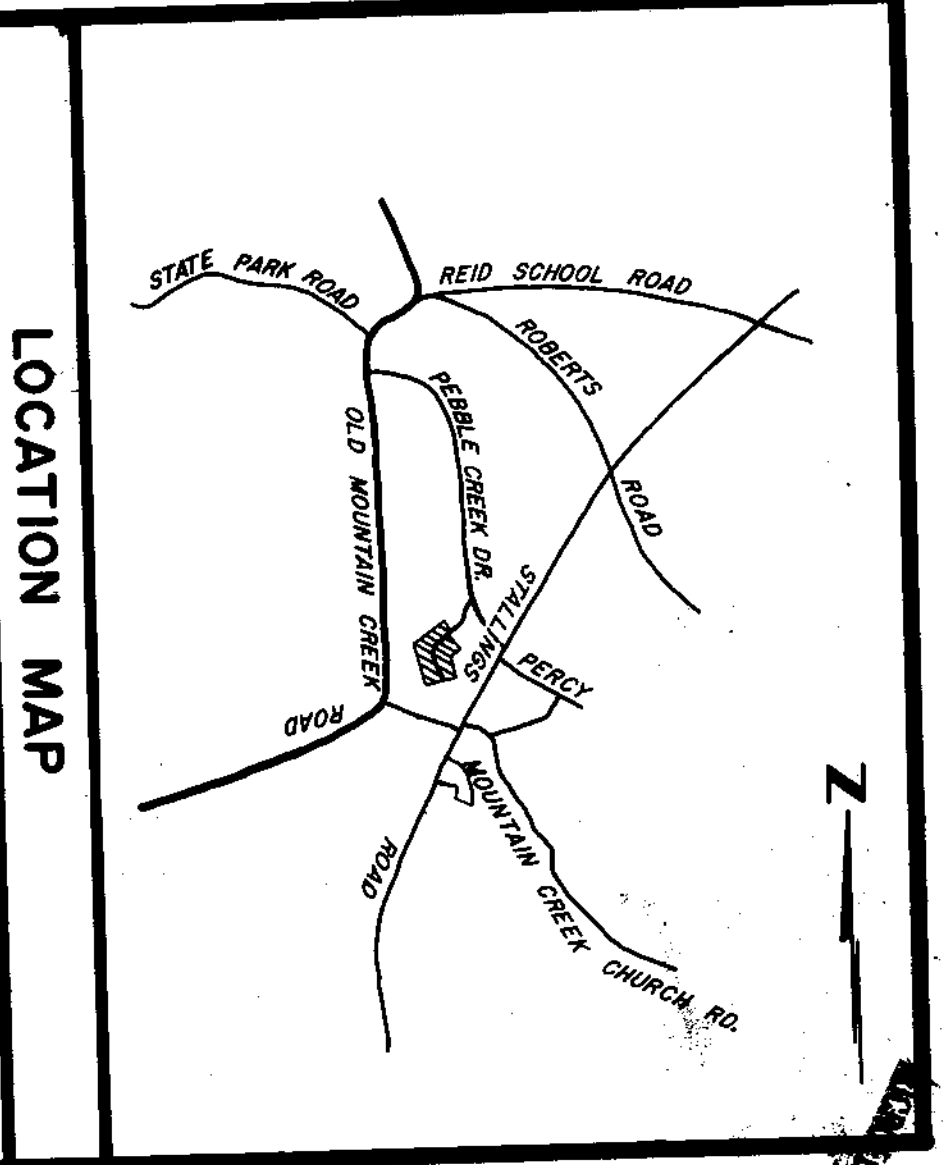

LOCATION MAP

# FINAL PLAT

## CERTIFICATE OF OWNERSHIP AND DEDICATION

"The undersigned hereby acknowledge that I am (we are) the owner(s) of the property shown and described hereon and that I (we) hereby adopt this plan of subdivision with my (our) free consent and that I (we) establish the minimum building restriction lines, and hereby dedicate to public use as road, street, and easements, shown all areas so shown or indicated on said plat.

1-15-79

Signed \_\_\_\_\_  
 Signed \_\_\_\_\_  
 Signed \_\_\_\_\_

## CERTIFICATE OF ACCURACY

"I, JAMES R. FREELAND, certify that this plat was (were) by me (them) drawn under my supervision (an actual survey made under my supervision) from (an actual survey made by me) (said description recorded in Book \_\_\_\_\_ Page 60-7-7-8-9-2394-2