


MICROFILMED

CEDAR FALLS ROAD

MC KELLY ROAD
(CLICKVILLE ROAD)

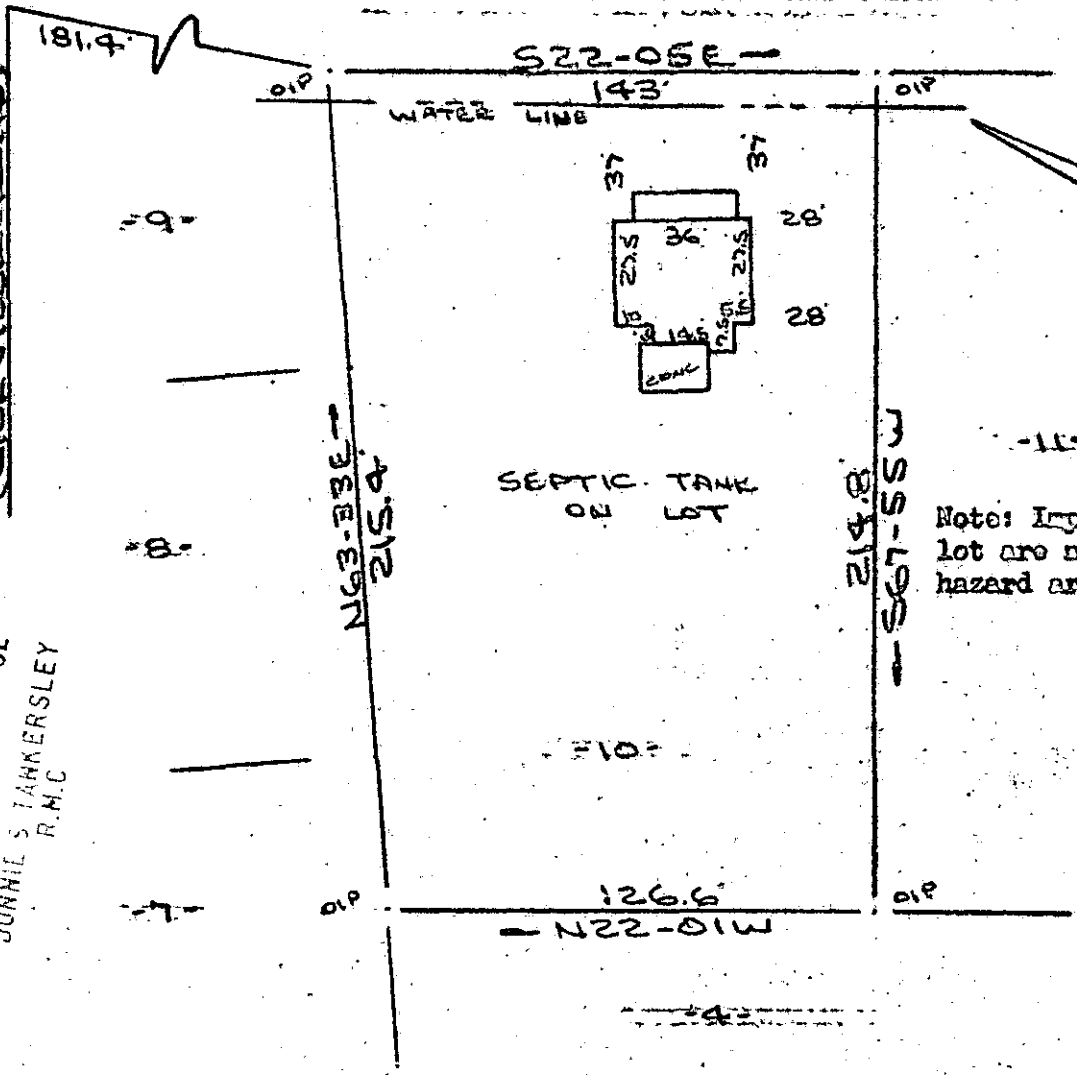

Note: Improvements on this lot are not in a flood hazard area.

FILED
AUG 13 4 30 PM '82
DONNIE S. TANKERSLEY
R.M.C.

PROPERTY OF
ROBERT LEONARD SIMS & LINDA F. SIMS
GREENVILLE COUNTY, S.C.
SCALE 1" = 50' 26 JULY 1982



This is to certify that on the 26th day of July, 1982, I surveyed the property shown on this plat, being known as lot 10 on plat of FOUR GOALS, S. C. OF RIDGEL TEXTILE CORPORATION and recorded in the REC Office Greenville County, S. C., in Plat Book "EB" at Page 157; and that the property lines, walls and buildings are as shown hereon, and that the walls and buildings located on said lot do not encroach or project on adjacent street or property, and that no adjacent walls or buildings encroach or project on said premises, and no power lines cross this property except as shown hereon.

AUG 13 1982

9-E-38


3763

R. B. Briscoe

R. B. Briscoe, R.L.S. 1982

CAROLINA SURVEYING CO.

112 Main St.
Greenville, S.C. 29601

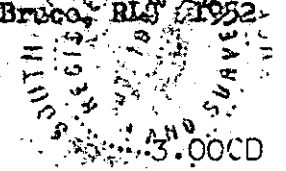

3.0000