


This is to certify that on August 25, 1982, I surveyed the property shown on this plat, known as part of Lot 85 on plat of Devenger Place, Sec. 2, recorded in the RMC Office of Greenville County in Plat Book 5D on page 8, and that the property lines, walls and buildings are as shown hereon; that the building located on said lot does not encroach or project on adjacent streets or property and that no adjacent walls or buildings encroach or project on said premises, and that no utility lines cross this property except as shown hereon. This property is not located in a designated flood hazard area.

5' drainage and utility easement along all side and rear lot lines. AUG 26 1982

9-E-60

*James R. Freeland*  
James R. Freeland PLS & PE 4781

4792

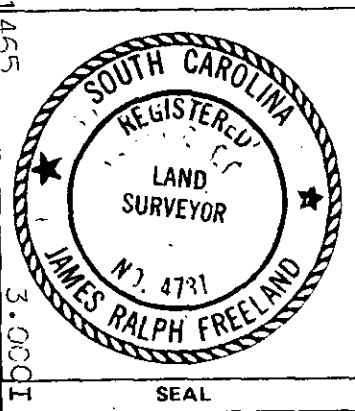

STATE OF SOUTH CAROLINA  
GREENVILLE COUNTY

DEVENGER PLACE  
SEC. 2 - PART LOTS 84 & 85  
PROPERTY OF  
PREMIER INVESTMENT  
CO. INC.

FREELAND & ASSOCIATES  
Engineers • Land Surveyors

GREENVILLE, S.C.

SURVEY LT  
DRAWN MC  
CHECK MC  
SCALE 1" = 40'  
DATE 8-25-82  
DWG. NO. 82-7794