


MICROFILMED

AF 10505

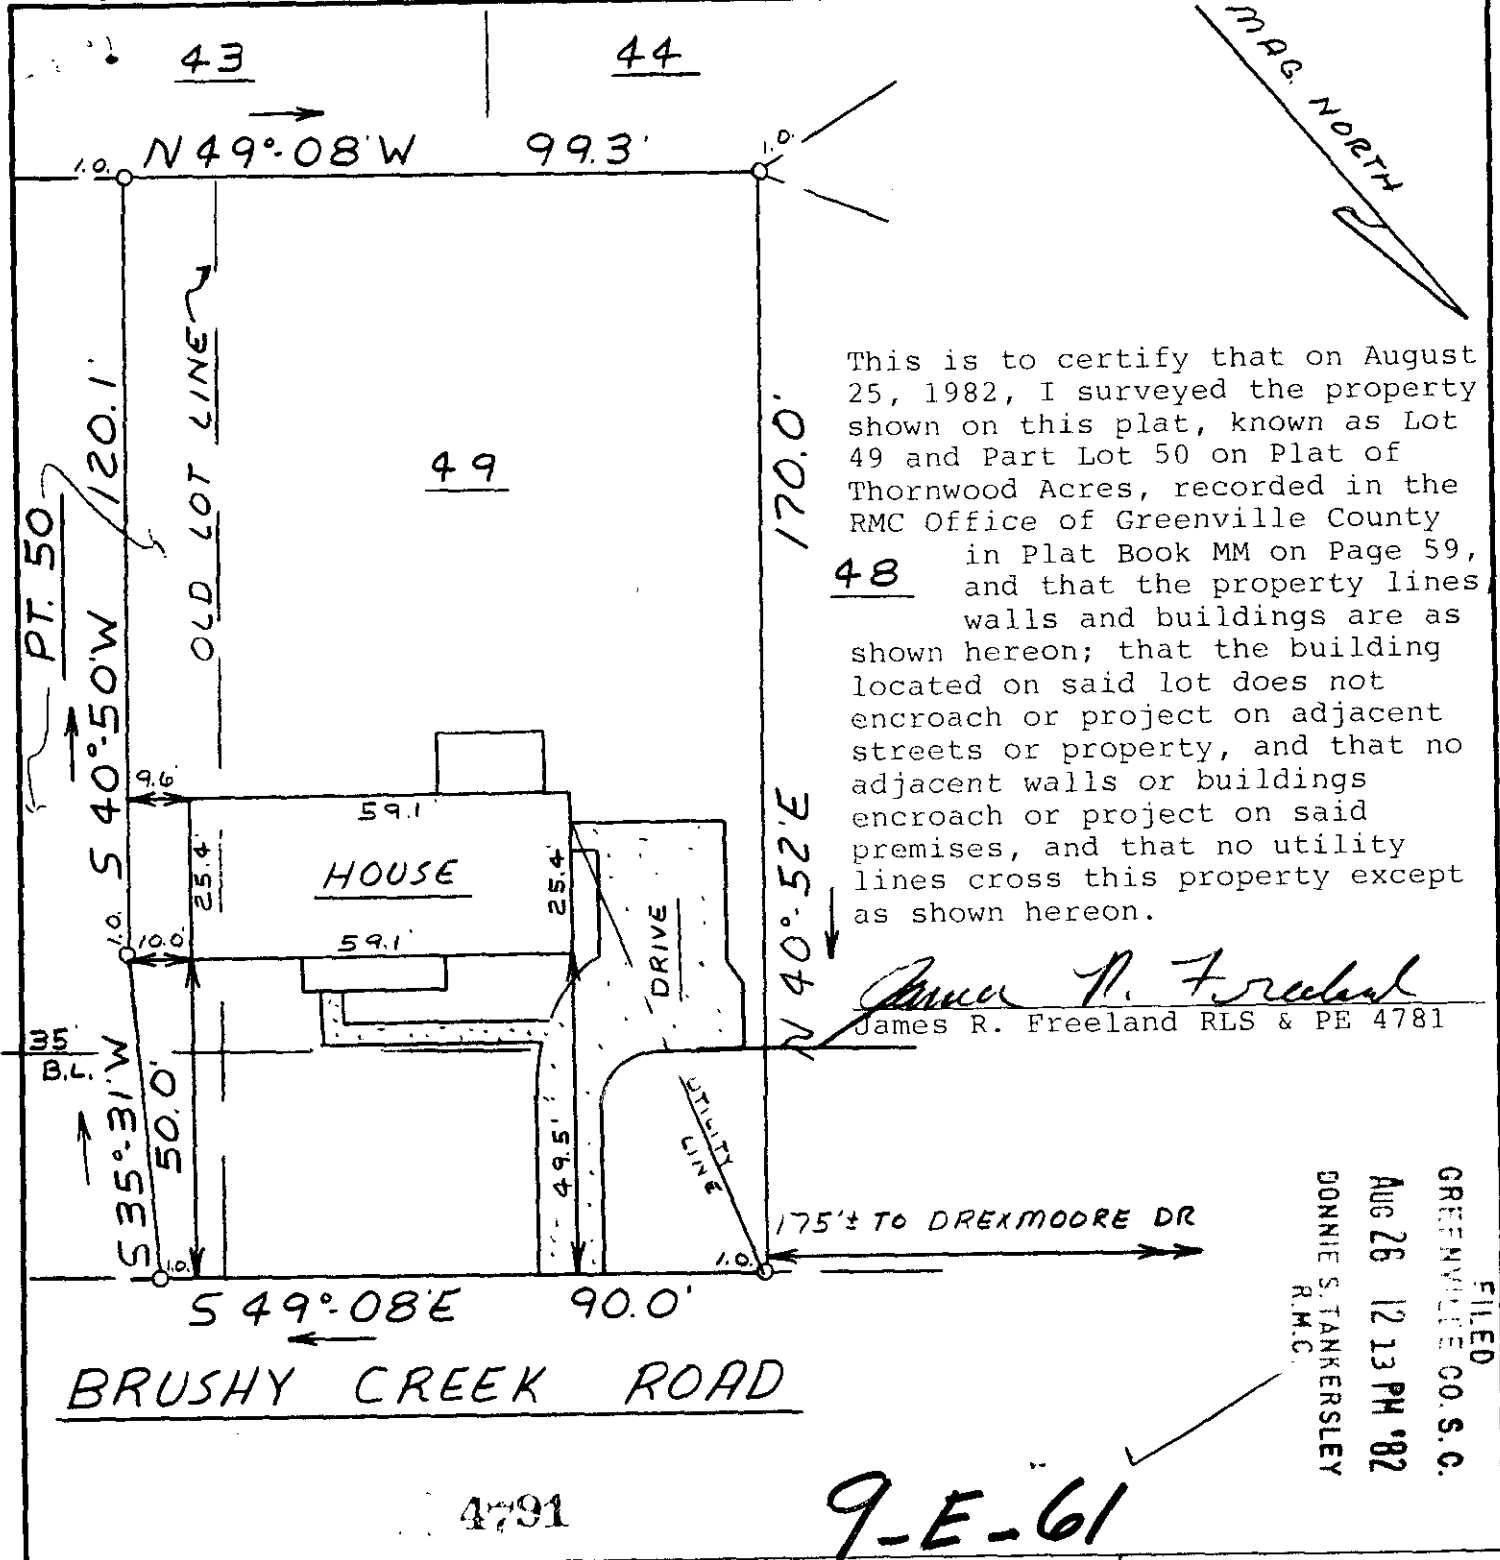

This is to certify that on August 25, 1982, I surveyed the property shown on this plat, known as Lot 49 and Part Lot 50 on Plat of Thornwood Acres, recorded in the RMC Office of Greenville County 48 in Plat Book MM on Page 59, and that the property lines walls and buildings are as shown hereon; that the building located on said lot does not encroach or project on adjacent streets or property, and that no adjacent walls or buildings encroach or project on said premises, and that no utility lines cross this property except as shown hereon.


James R. Freeland
James R. Freeland RLS & PE 4781

FILED
GREENVILLE CO. S.C.
AUG 26 12 13 PM '82
DONNIE S. TANKERSLEY
R.M.C.

BRUSHY CREEK ROAD

4791

9-E-61

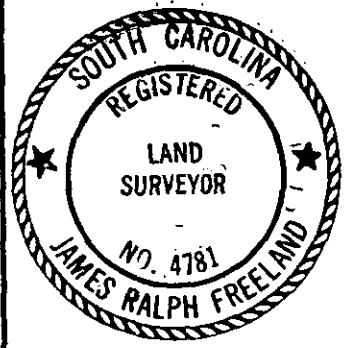

STATE OF SOUTH CAROLINA
GREENVILLE COUNTY

THORNWOOD ACRES
LOTS 49 & PT. 50
PROPERTY OF
PREMIER INVESTMENT
CO. INC.

FREELAND & ASSOCIATES
Engineers • Land Surveyors

GREENVILLE, S.C.

SURVEY	LT
DRAWN	MC
CHECK	MC
SCALE	1" = 30'
DATE	8-25-82
DWG. NO.	82-7800

2 AU26 82 1476

3.0001