


(PT. 548.2-1-18.1)

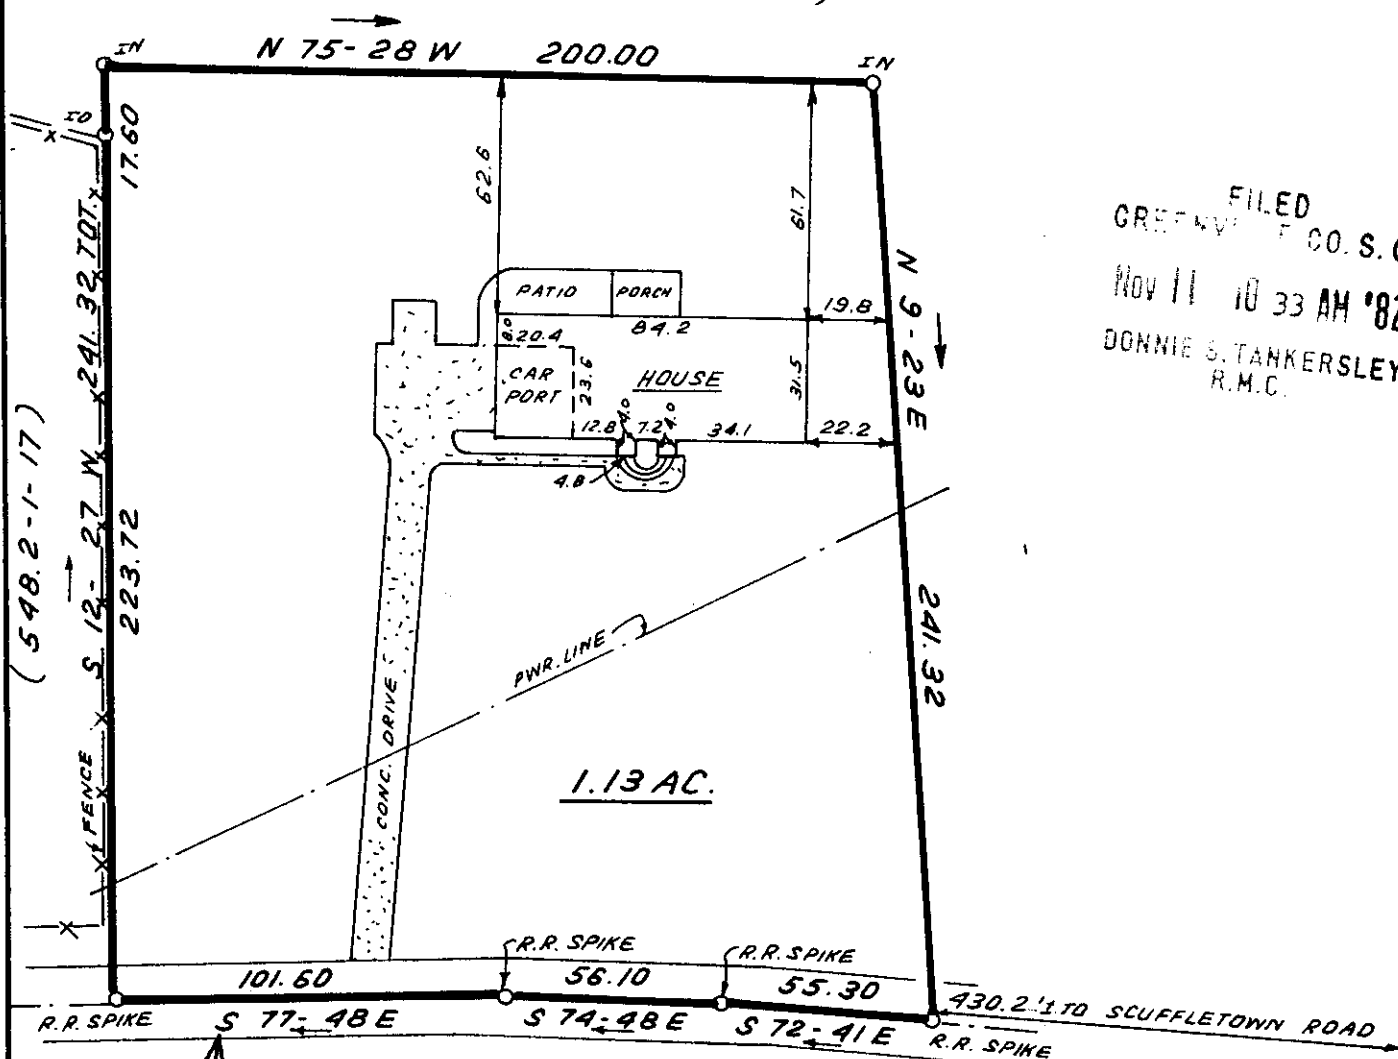

FILED  
 GREENVILLE CO. S. C.  
 NOV 11 10 33 AM '82  
 DONNIE S. TANKERSLEY  
 R.M.C.

**GRESHAM RD.**


NOTE: 40' RIW BY EASEMENT

I hereby certify that the ratio of precision of the field survey is 1/5,000 as shown hereon and the area was determined by DMD Method.

*James R. Freeland*  
 James R. Freeland RLS & PE 4781



MAG NORTH  
 3 NO 11 82  
 GCTO

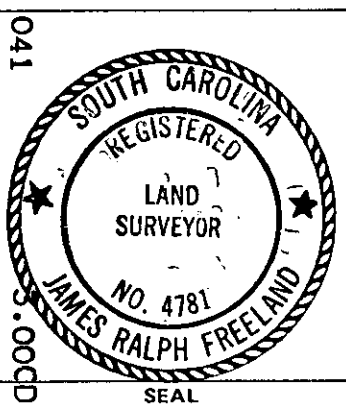

STATE OF SOUTH CAROLINA  
 GREENVILLE COUNTY

11526

SURVEY FOR  
**9I-27**  
 FIVE FORKS BAPTIST CHURCH

FREELAND & ASSOCIATES Engineers • Land Surveyors
GREENVILLE, S.C.
SURVEY L.T. & F.E.L.
DRAWN B.R.
CHECK MLC
SCALE 1" = 50'
DATE NOV. 3. 82
DWG. NO. 8029