




This is to certify that on May 19, 1983, I surveyed the property shown on this plat, known as Lot 99 on Plat of Westwood South, Sec. 2, recorded in the RMC Office of Greenville County in Plat Book 7C on Page 65, and that the property lines, walls and buildings are as shown hereon; that the building located on said lot does not encroach or project on adjacent streets or property, and that no adjacent walls or buildings encroach or project on said premises, and that no utility lines cross this property except as shown hereon. This property is not located in a designated flood hazard area.

*James R. Freeland*  
James R. Freeland RLS & PE  
4781

FILED  
GREENVILLE CO. CLERK  
MAY 23 4 30 PM 1983  
DONNIE S. JAMES  
R.M.C. SEER

5' drainage & utility easement each side and rear lot lines

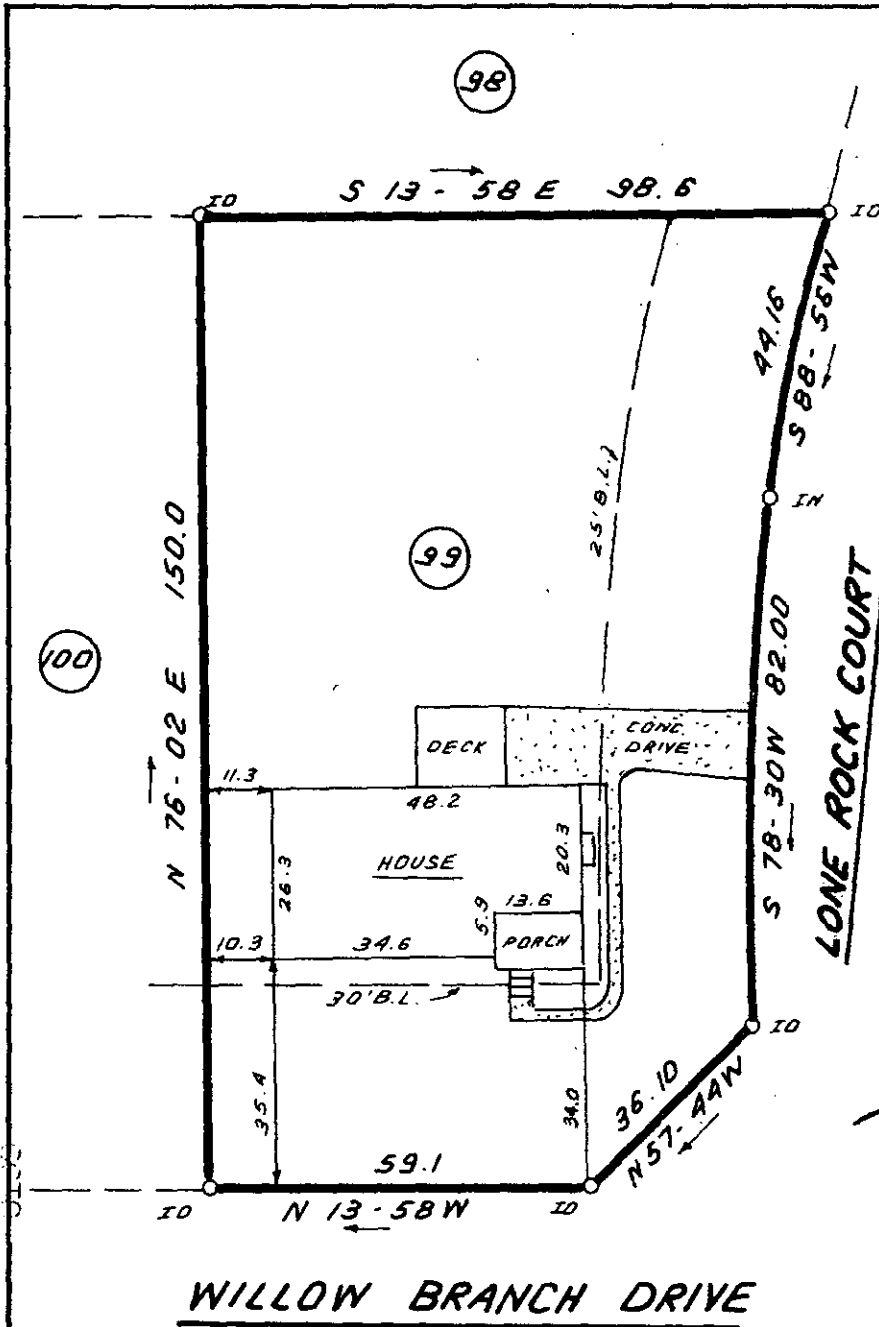

**WILLOW BRANCH DRIVE**

*9-T-2*

31194



**STATE OF SOUTH CAROLINA  
GREENVILLE COUNTY**

FREELAND & ASSOCIATES  
Engineers • Land Surveyors

GREENVILLE, S.C.

WESTWOOD SOUTH  
SEC. 2; LOT 99  
PROPERTY OF  
DAVID E. JONES  
WANDA F. WATSON

SURVEY	L.T.
DRAWN	B.R.
CHECK	ML
SCALE	1" = 30'
DATE	MAY 13, 83
DWG. NO.	8972

THE PRINT MACHINE, INC. N30031 3-0061