


FILED
GREENVILLE CO. S. C.
MAY 27 4 27 PM '83
DONNIE S. TANKERSLEY
R.M.C.

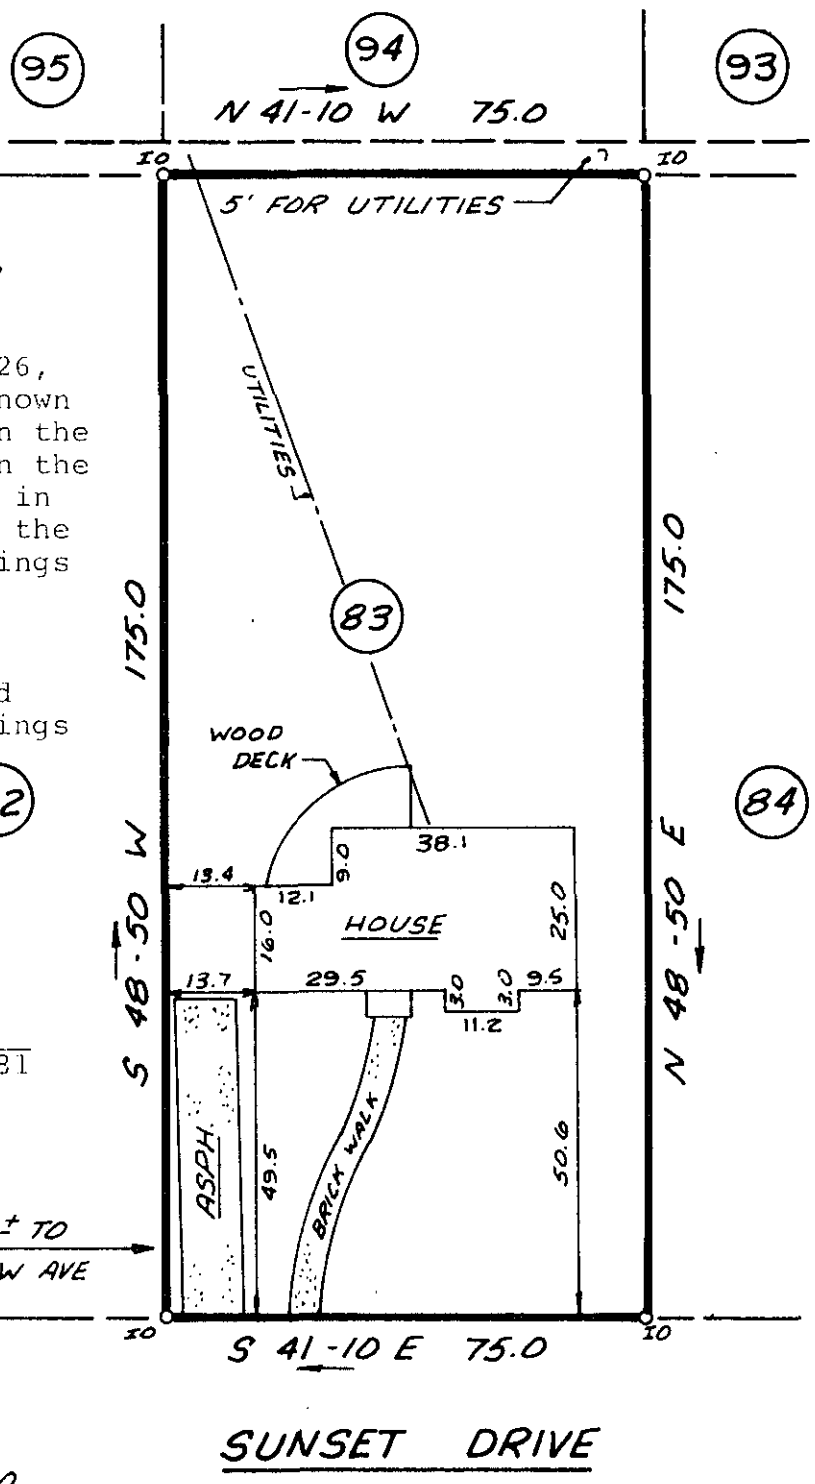

This is to certify that on May 26, 1983, I surveyed the property shown on this plat, known as Lot 83 on the plat of Sunset Hills, recorded in the RMC Office of Greenville County in Plat Book P on page 18 and that the property lines, walls and buildings are as shown hereon; that the building located on said lot does not encroach or project on adjacent streets or property and that no adjacent walls or buildings encroach or project on said premises, and that no utility lines cross this property except as shown hereon. This property is not located in a designated flood hazard area.

James R. Freeland
James R. Freeland PE and PLS 4781

97-41

450' ± TO
WACCAMAW AVE

31848

MAY 27 1983

30
0
30
60
SCALE
FEET
073
3
0023



STATE OF SOUTH CAROLINA
GREENVILLE COUNTY

SUNSET HILLS
LOT 83
PROPERTY OF
BENJAMIN E. WILLINGHAM JR.
DEBORAH D. WILLINGHAM

FREELAND & ASSOCIATES Engineers • Land Surveyors	
GREENVILLE, S.C.	
SURVEY	L.T.
DRAWN	K.E.G.
CHECK	MC
SCALE	1"=30'
DATE	5-26-83
DWG. NO.	9023

THE PRINT MACHINE, INC. "3035"