MICROFILMED "THIS PLAT TO BE RECORDED IN THE R.M.C. OFFICE."

"THIS PROPERTY IS NOT LOCATED IN A FLOOD PLAIN" PER N.G.S.

FILED
GREENVILLE CO. S. C.
JUN 1 11 45 AM '83
DONNIE S. TANKERSLEY
R.M.C.

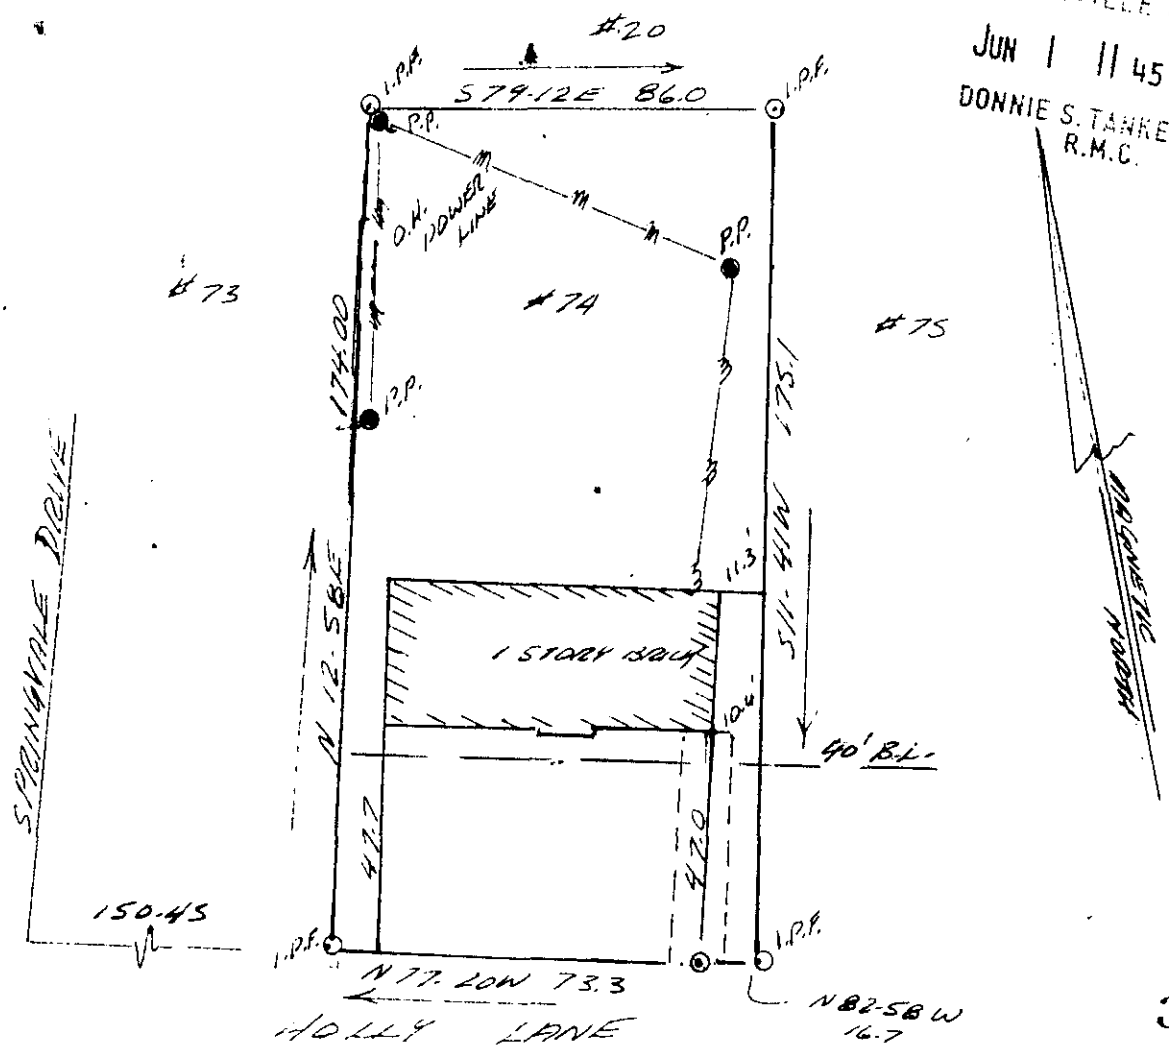

32472

✓ 9-T-71

JOSEPH D. SMITH and HELEN C. SMITH

JUN 1 1983

THIS IS TO CERTIFY THAT ON THE 31ST DAY OF MAY, 1983, I SURVEYED THE PROPERTY SHOWN ON THIS PLAT, BEING KNOWN AS LOT #74 ON PLAT OF Holly Springs II AND RECORDED IN THE R. M. C. OFFICE Greenville COUNTY, S. C. IN Plat BOOK 4R AT PAGE 54; AND THAT THE PROPERTY LINES, WALLS, AND BUILDINGS ARE SHOWN HEREON, AND THAT THE WALLS AND BUILDINGS LOCATED ON SAID LOT DO NOT ENCROACH OR PROJECT ON ADJACENT STREETS OR PROPERTY, AND THAT NO ADJACENT WALLS OR BUILDINGS ENCROACH OR PROJECT ON SAID PREMISES, AND NO POWER LINES CROSS THIS PROPERTY EXCEPT AS SHOWN HEREON.

0' 40' 80' 120'

"THIS IS TO CERTIFY THAT THE ERROR OF CLOSURE OF THIS SURVEY IS 1 IN 3000±, AND THE ACREAGE HAS BEEN DETERMINED BY THE D.M.D. METHOD."

SOUTH CAROLINA REGISTERED LAND SURVEYOR NO. 4552 JOSEPH LANHAM MONTGOMERY

J. L. MONTGOMERY, III
R. L. S. No. 4552
Simpsonville, S. C.
41371A01