


FILED
GREENVILLE CO. S. C.
JUL 5 11 38 AM '83
DONNIE S. TANKERSLEY
R.M.C.

This is to certify that on June 25, 1983, I surveyed the property shown on this plat, known as the property of Barbara S. Hughes recorded in the RMC Office of Greenville County in Deed Book 808 on page 300 and that the property lines, walls and buildings are as shown hereon; that the building located on said lot does not encroach or project on adjacent streets or property and that no adjacent walls or buildings encroach or project on said premises, and that no utility lines cross this property except as shown hereon. This property is not located in a designated flood hazard area.

GARRAUX STREET

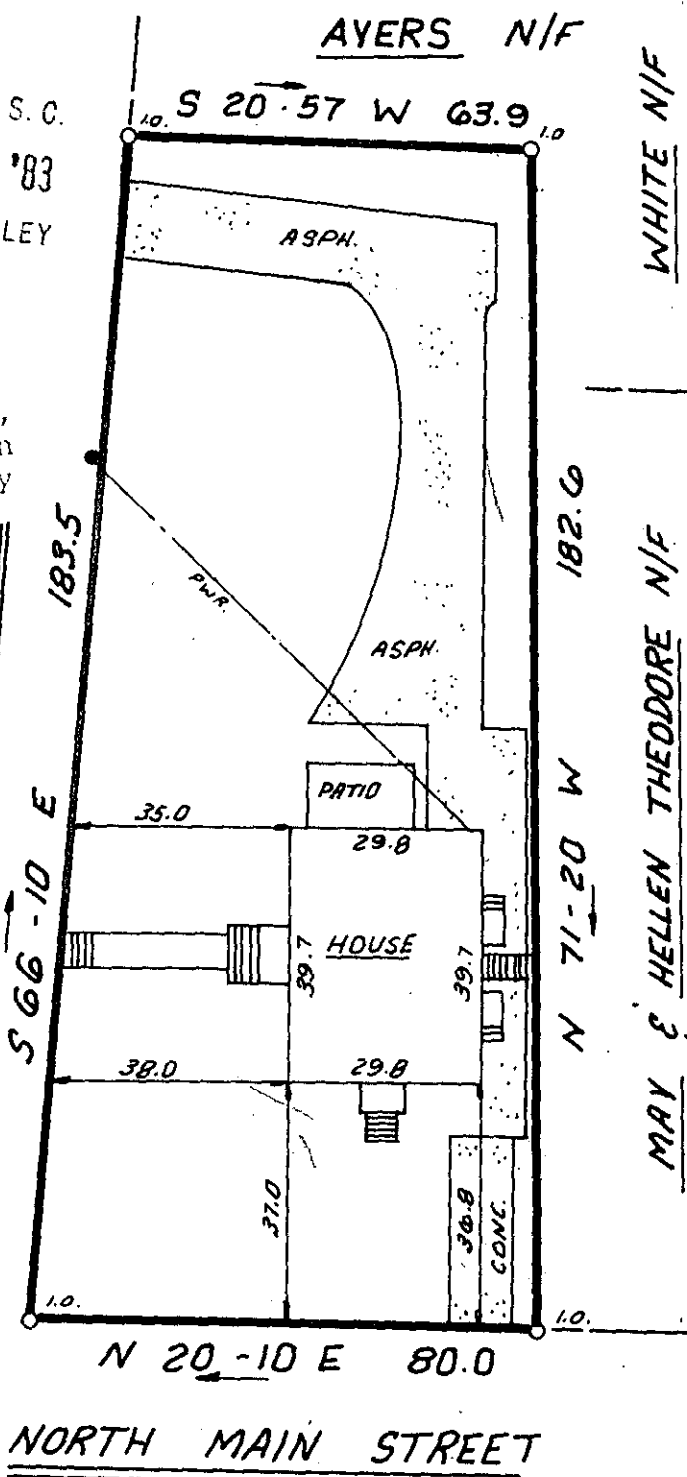


WHITE N/F
MAY & HELEN THEODORE N/F

James R. Freeland
James R. Freeland PE and PLS
4781

JUL 5 1983

✓ 9-V-1 390

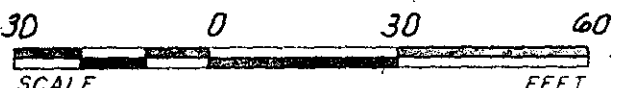

STATE OF SOUTH CAROLINA
GREENVILLE COUNTY

PROPERTY OF
BARBARA S. KEENEY

FREELAND & ASSOCIATES
Engineers • Land Surveyors
GREENVILLE, S.C.

SURVEY	J.E.C.
DRAWN	K.E.G.
CHECK	M.C.
SCALE	1" = 30'
DATE	6-25-83
DWG. NO.	9229