


MICROFILMED

FILED
GREENVILLE CO S.C

JUL 11 1 56 PM '83

DONNIE S. TANKERSLEY
R.M.C

BROOKWOOD DR

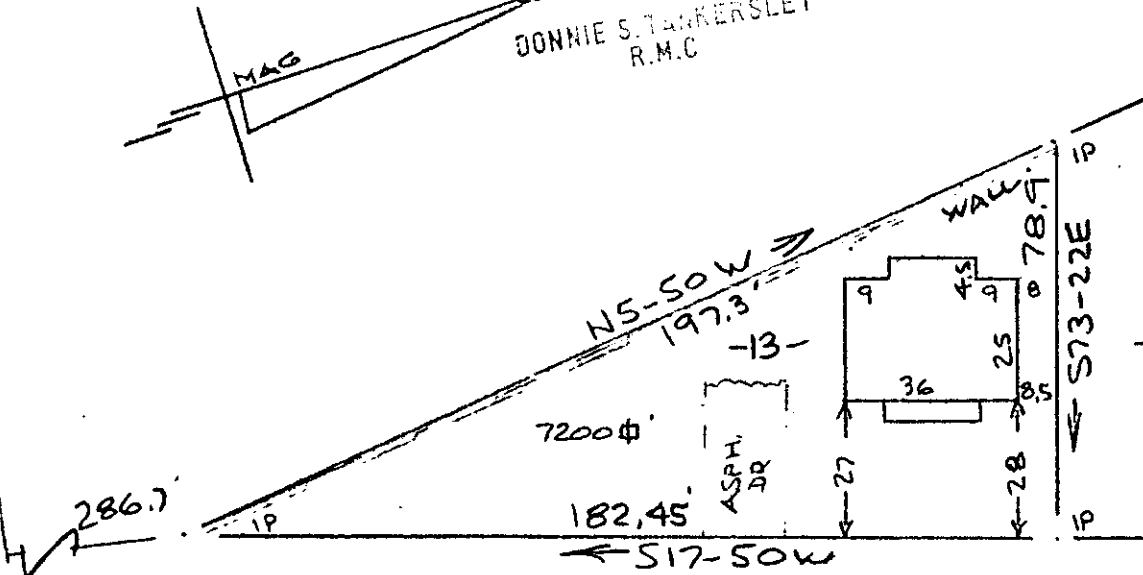

MELVILLE AVE
WATER & SEWER IN ST R/W

Note: Improvements on this lot
are not in a flood hazard
area.

PROPERTY OF
DAVID W. GLENN & PAUL ALLEN McDONALD
GREENVILLE, S. C.

40' 21 APR 1983 40'

This is to certify that on the 21st day of April, 1983, I surveyed the property shown on this plat, being known as lot 13 on plat of PROPERTY OF DAVID W. GLENN & PAUL ALLEN McDONALD and recorded in the RMC Office Greenville County, S. C., in Plat Book 9-V at Page 22 ; and that the property lines, walls and buildings are as shown hereon, and that the walls and buildings located on said lot do not encroach or project on adjacent street or property, and that no adjacent walls or buildings encroach or project on said premises, and no power lines cross this property except as shown hereon.

1062

✓ 9-V-22

JUL 11 1983

R. B. Bruce
R. B. Bruce, RLS 1952



CAROLINA SURVEYING CO.
112 Manly St.
Greenville, S. C.

5070
2 JUL 11 83
437
3.00CI

246/78

216-1-5