

FILED  
 GREENVILLE CO. S.C.  
 JUL 27 2 14 PM '83  
 DONNIE S. JANKERSLEY  
 R.M.C.

**GATEWAY**

This is to certify that on July 19, 1983, I surveyed the property shown on this plat, known as Lot 56 on Plat of Merrifield Park, Sec. 2, recorded in the RMC Office of Greenville County in Plat Book WVVV on Page 50, and that the property lines, walls and buildings are as shown hereon; that the building located on said lot does not encroach or project on adjacent streets or property; and that no adjacent walls or buildings encroach or project on said premises, and that no utility lines cross this property except as shown hereon. This property is not located in a designated flood hazard area.

*James R. Freeland*  
 James R. Freeland RLS & PE 4781


JUL 27 1983

3016



9-V-84

**STATE OF SOUTH CAROLINA  
 GREENVILLE COUNTY**

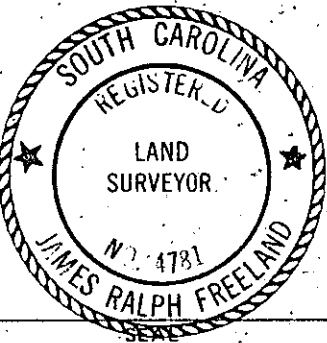

MERRIFIELD PARK  
SEC. 2, LOT 56  
PROPERTY OF  
GEORGE S. BOULOS  
CATHERINE M. BOULOS

FREELAND & ASSOCIATES Engineers & Land Surveyors	
GREENVILLE, S.C.	
SURVEY	H. B.
DRAWN	B. R.
CHECK	M. C.
SCALE	1" = 40'
DATE	JULY 19, 83
DWG. NO.	9367 3-0000