
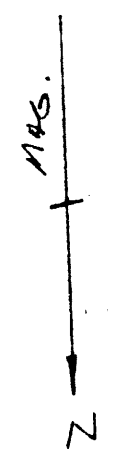


FILED
 GREENVILLE S.C.
 OCT 6 3 54 PM '83
 DONNIE S. WATERSLEY
 R.M.C.

MICROFILMED

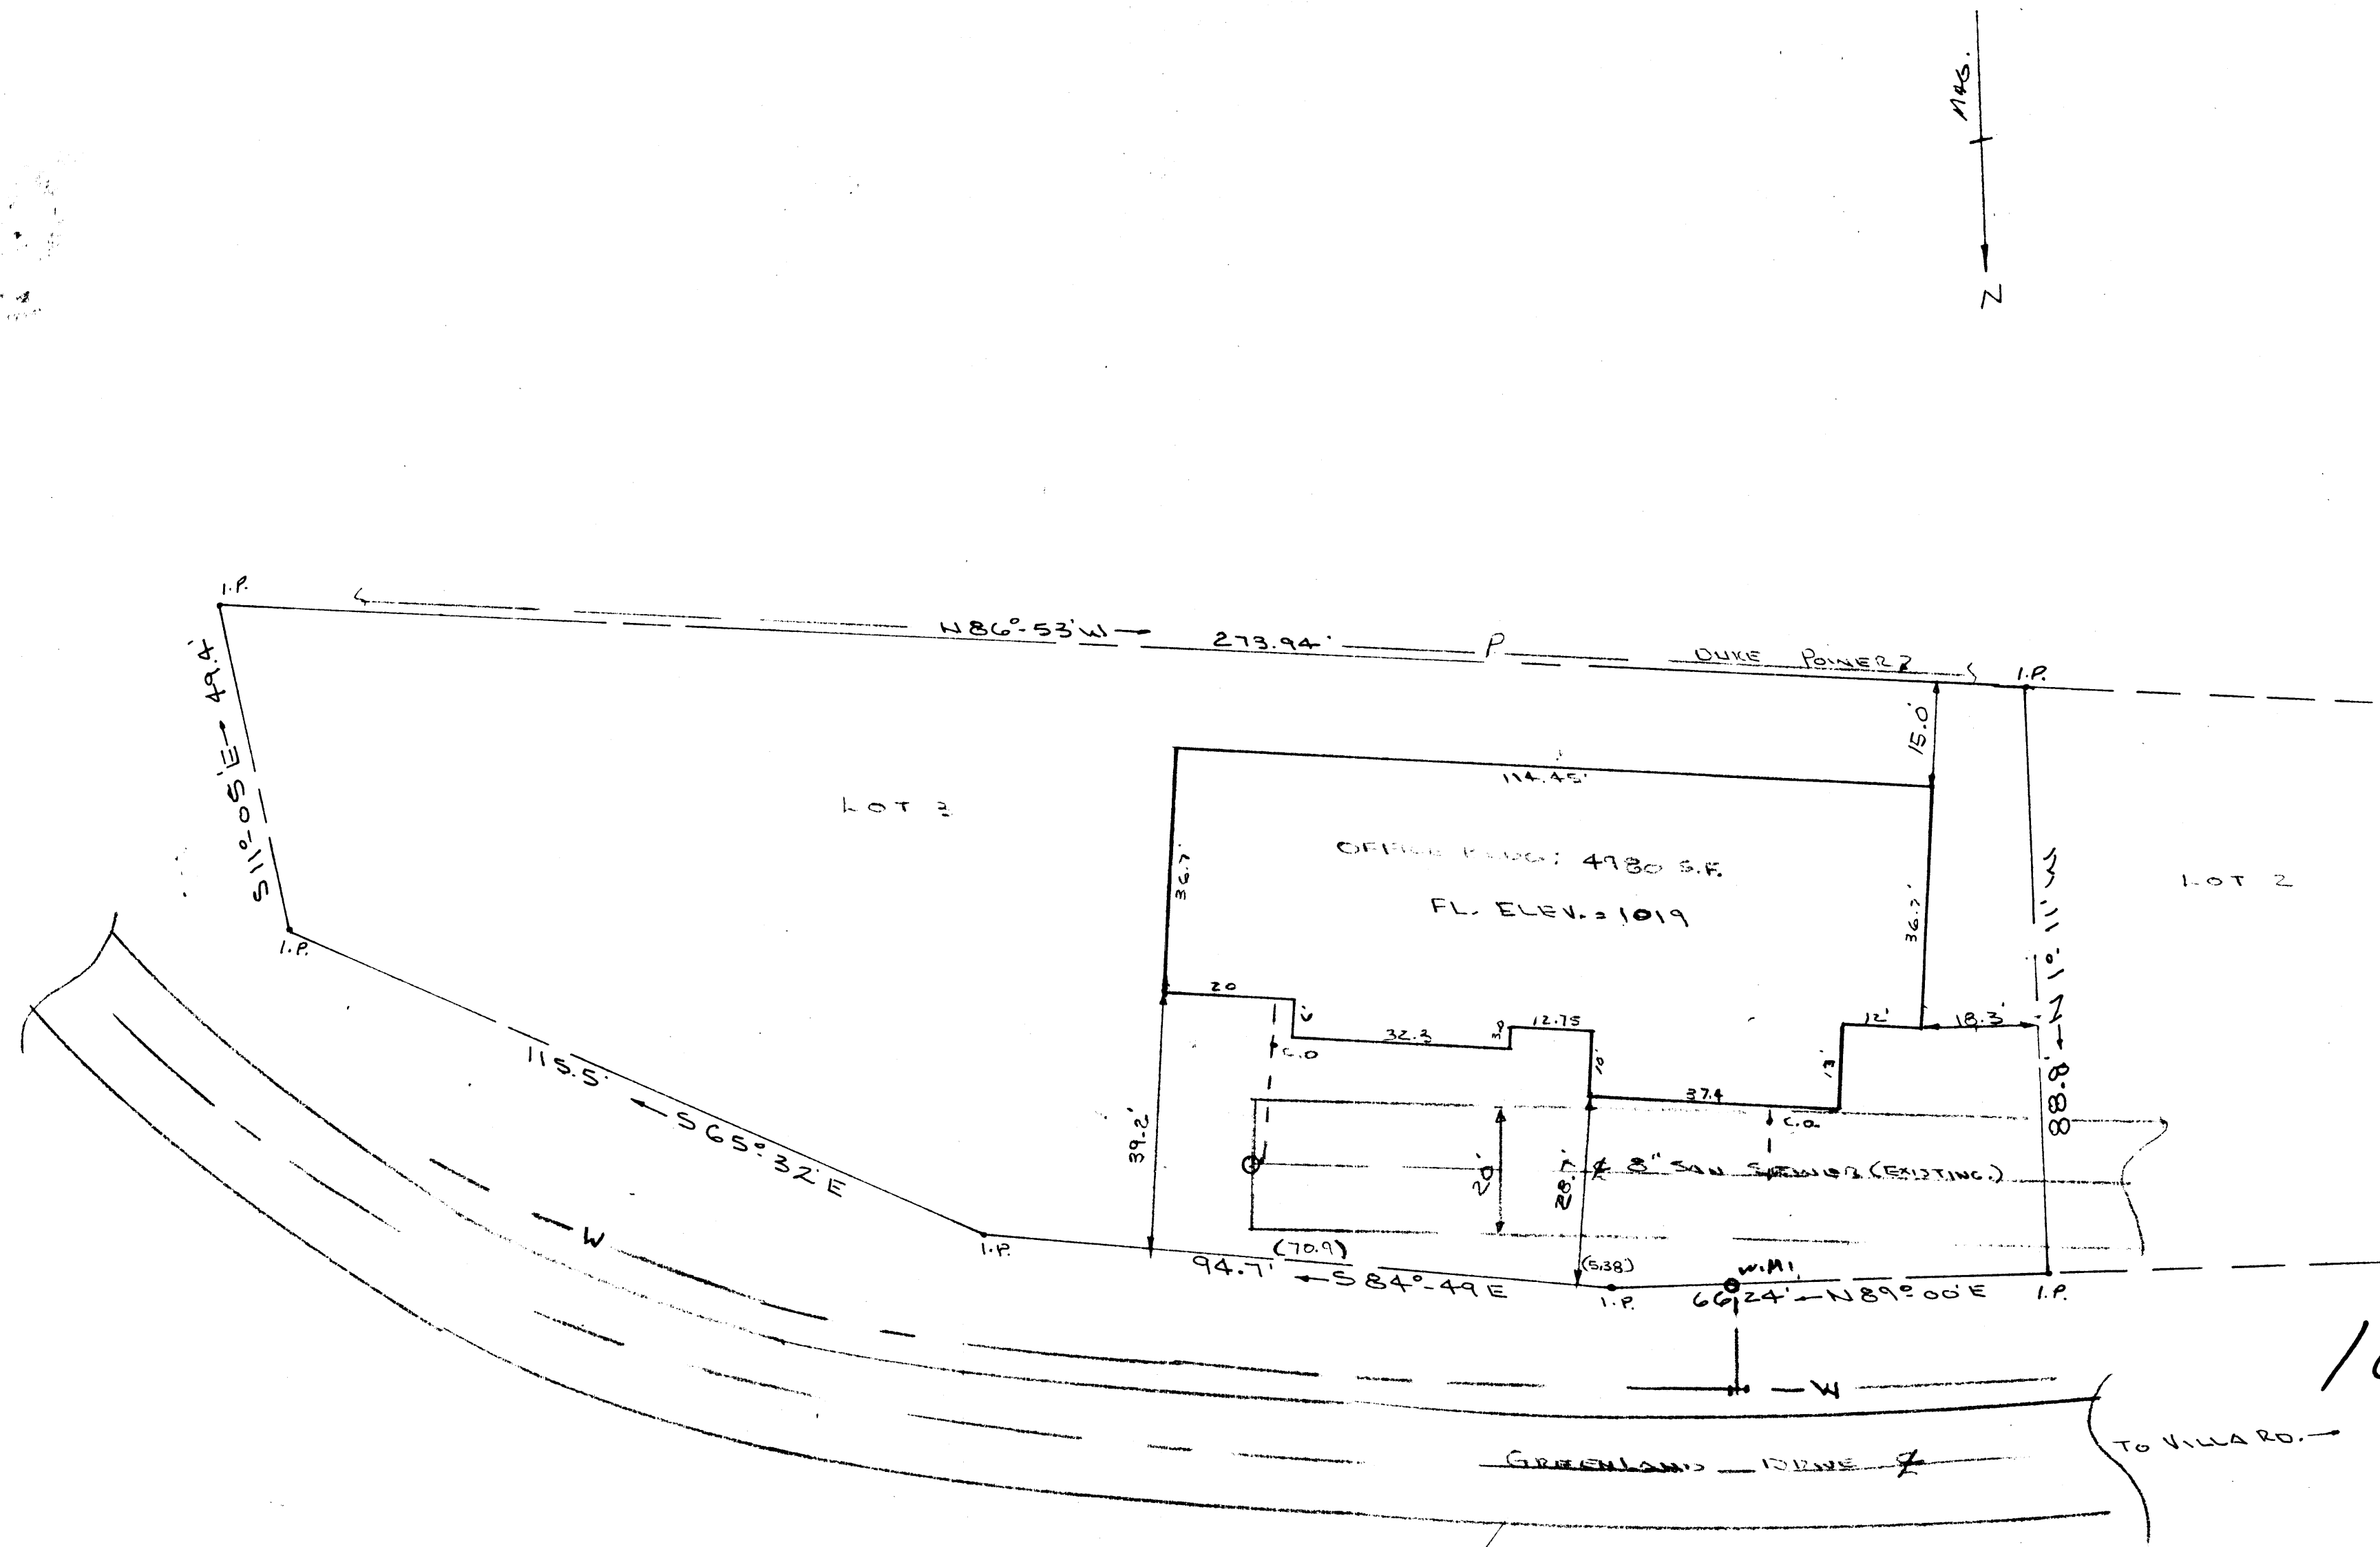



10-A-15

OCT 6 1983

FOUNDATION SURVEY MADE
 9-2-83 AS SHOWN.

REF: D. BK. 116, PG. 76
 PL. BK. 62, PG. 62
 TR. PG. 65
 BLK. BK. 24, (12)-519-280-1-523

I CERTIFY THE ABOVE LOT HAS BEEN
 SURVEYED AND IS AS SHOWN TO THE
 BEST OF MY KNOWLEDGE. THERE ARE NO
 ENCROACHMENTS AND LOT IS NOT LOCATED
 IN A FLOOD PLAIN AREA.

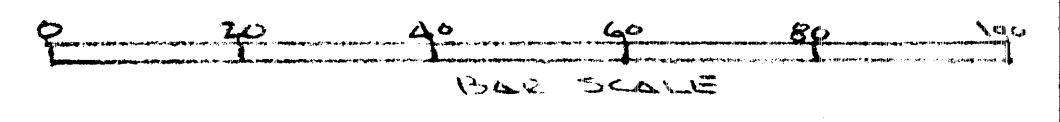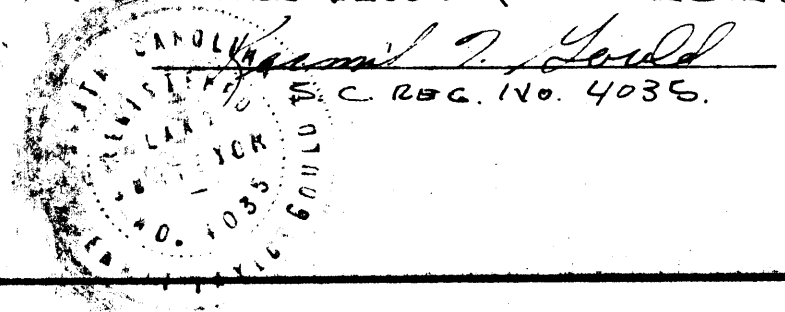

W. WILLIAM BASHOR, JR. JOHN F. PALMER		
SCALE 1" = 20'	APPROVED BY	DRAWN BY K. T. G.
DATE 9-2-83		
"GREENLAND CROSSING"		
LOT 3	22,084 S.F.	DRAWING NUMBER