


FILED
GREENVILLE CO. S.C.
JAN 19 2 19 PM '84
DORRIL S. HARRISLEY
R.M.C.

LAURENS ROAD

SYCAMORE DRIVE

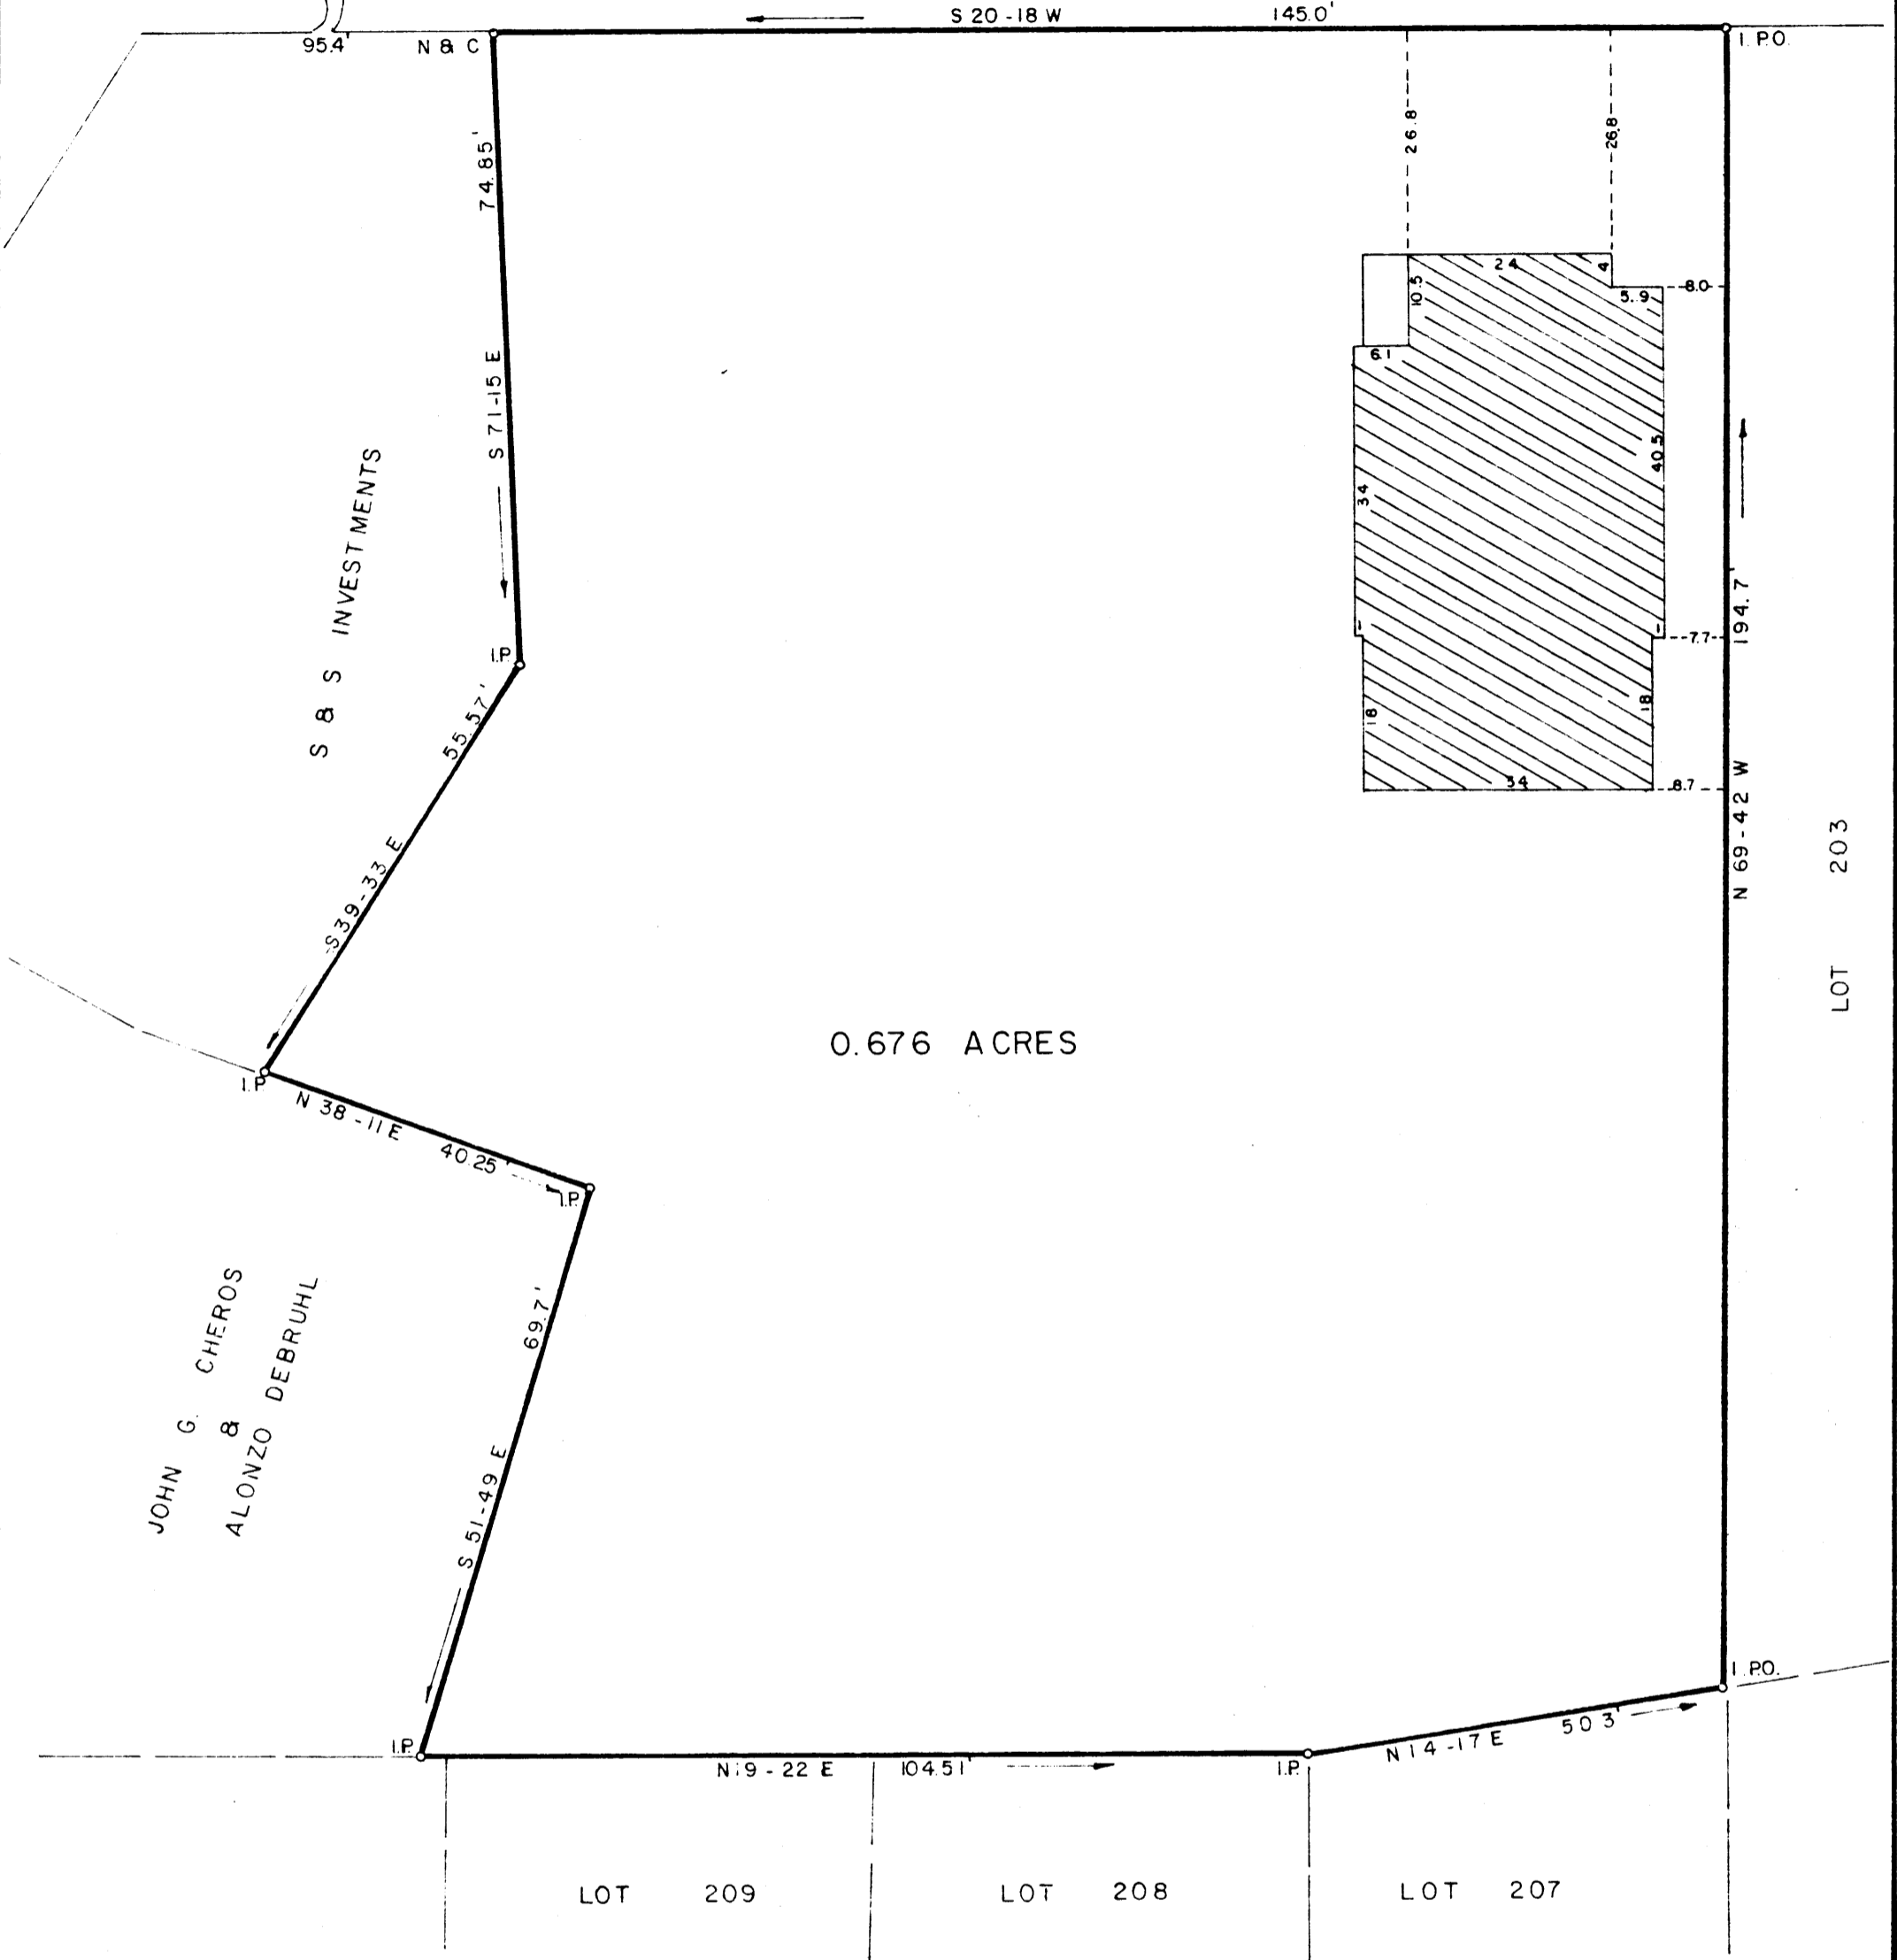

0.676 ACRES

JOHN G. CHEROS
&
ALONZO DEBRUHL

LOT 209

LOT 208

LOT 207

JAN 19 1984

PROPERTY OF
DEE A. SMITH

MOA-82

22515 ✓

GREENVILLE COUNTY, S. C.

Scale 1" = 20' January, 1984

This is to certify that on the 18th day of January, 1984, we surveyed the property shown on this plat, and that the property lines, walls and buildings are as shown hereon; that the buildings located on said lot do not encroach or project on adjacent streets or property; and that no adjacent buildings or walls encroach or project on said premises; and from information from Greenville County, this structure is not in a designated flood area.

DALTON & NEVES CO., INC. ENGINEERS