

○ = Existing Iron Pin, NIP = New Iron Pin, N/C = Nail & Cap, RR = Railroad Spike

REF PLAT

REF PLAT BK S
Pg 189 of ROCKWOOD PARK SUBDV & TAX MAP 519-214-3-31



FILED
GREENVILLE CO. S.C.
FEB 22 4 23 PM '84
DONNIE S. TANKERSLEY
R.M.C.




I CERTIFY THAT I SURVEYED THIS PROPERTY AND THE ERROR OF CLOSURE IS ± 7500"
THERE ARE NO ENCRUMBMENTS (EXCEPT AS SHOWN) ON THIS PROPERTY AND THIS PROPERTY DOES NOT
ENCRUMB ON ADJOINING PROPERTY AND THIS PROPERTY IS NOT LOCATED IN A FLOOD HAZARD AREA

SC BLS 6270

25834

✓ 10-I-17 Plat for FEB 22 1984

MARK K. JOHNSTON & SUSAN E. CYR	
SCALE: 1 inch = 40 feet	
JOB : 4181734	DATE: FEBRUARY 16, 1984
STATE: SOUTH CAROLINA	COUNTY: GREENVILLE
TWNSHP:	CITY: GREENVILLE
JOHN R LONG & ASSOCIATES 803-654-5033 GCTO CLEMSON SOUTH CAROLINA 5.00CI	

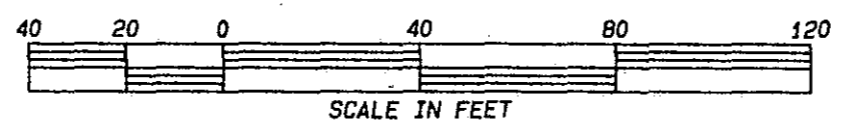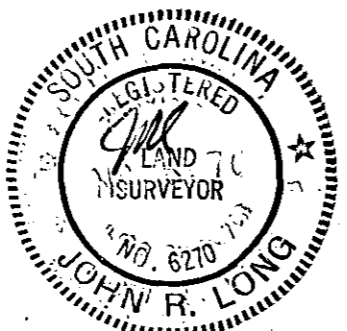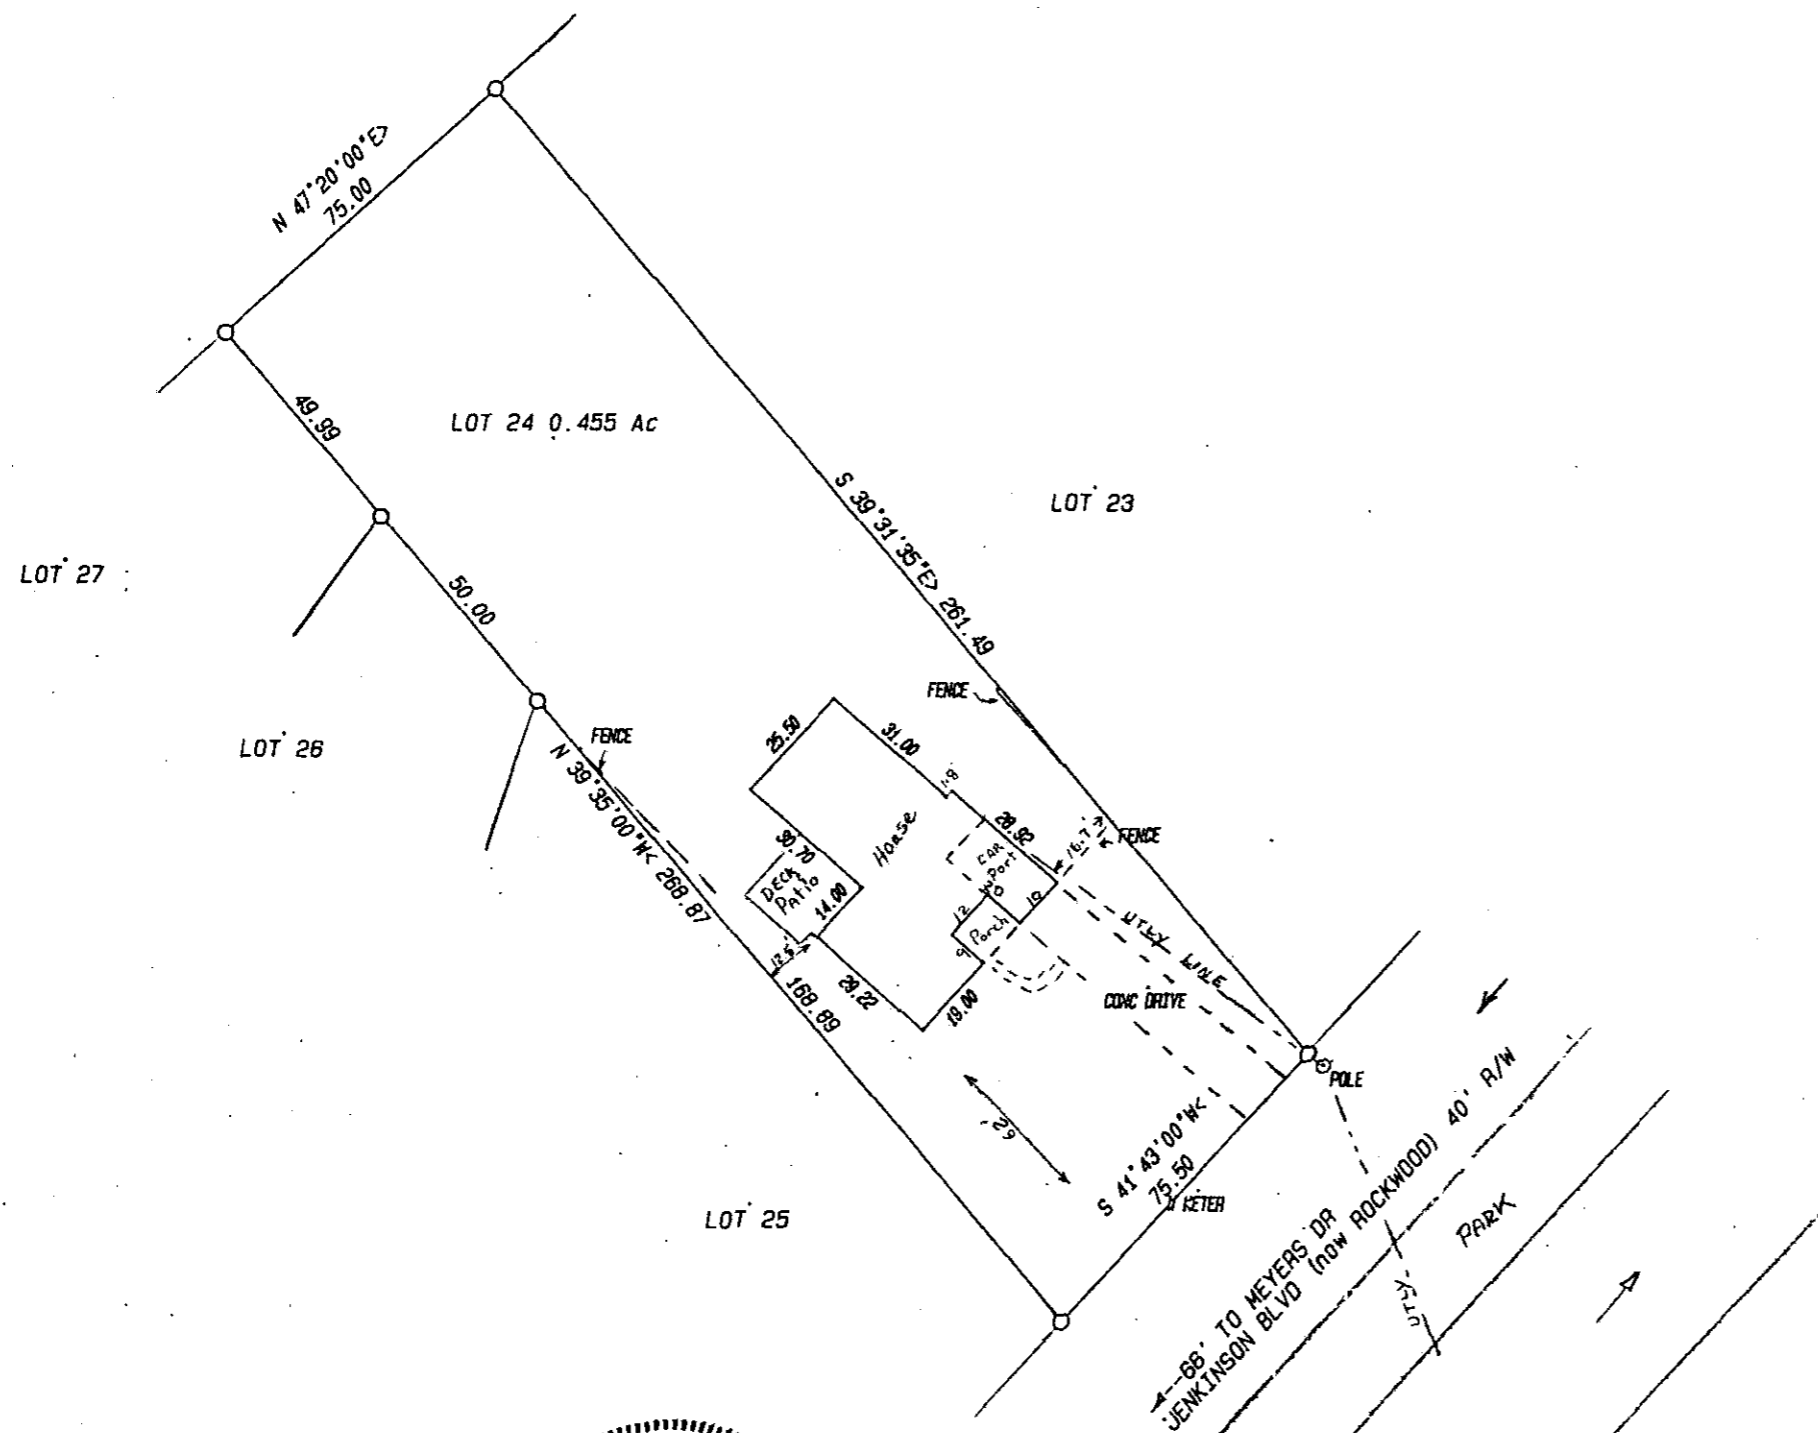

MICROFILMED