
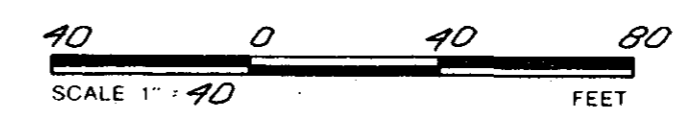
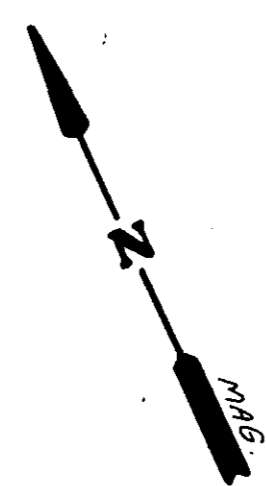


FILED
 GREENVILLE CO. S.C.
 MAR 5 10 55 AM '84
 DONNIE S. TANKERSLEY
 R.M.C.

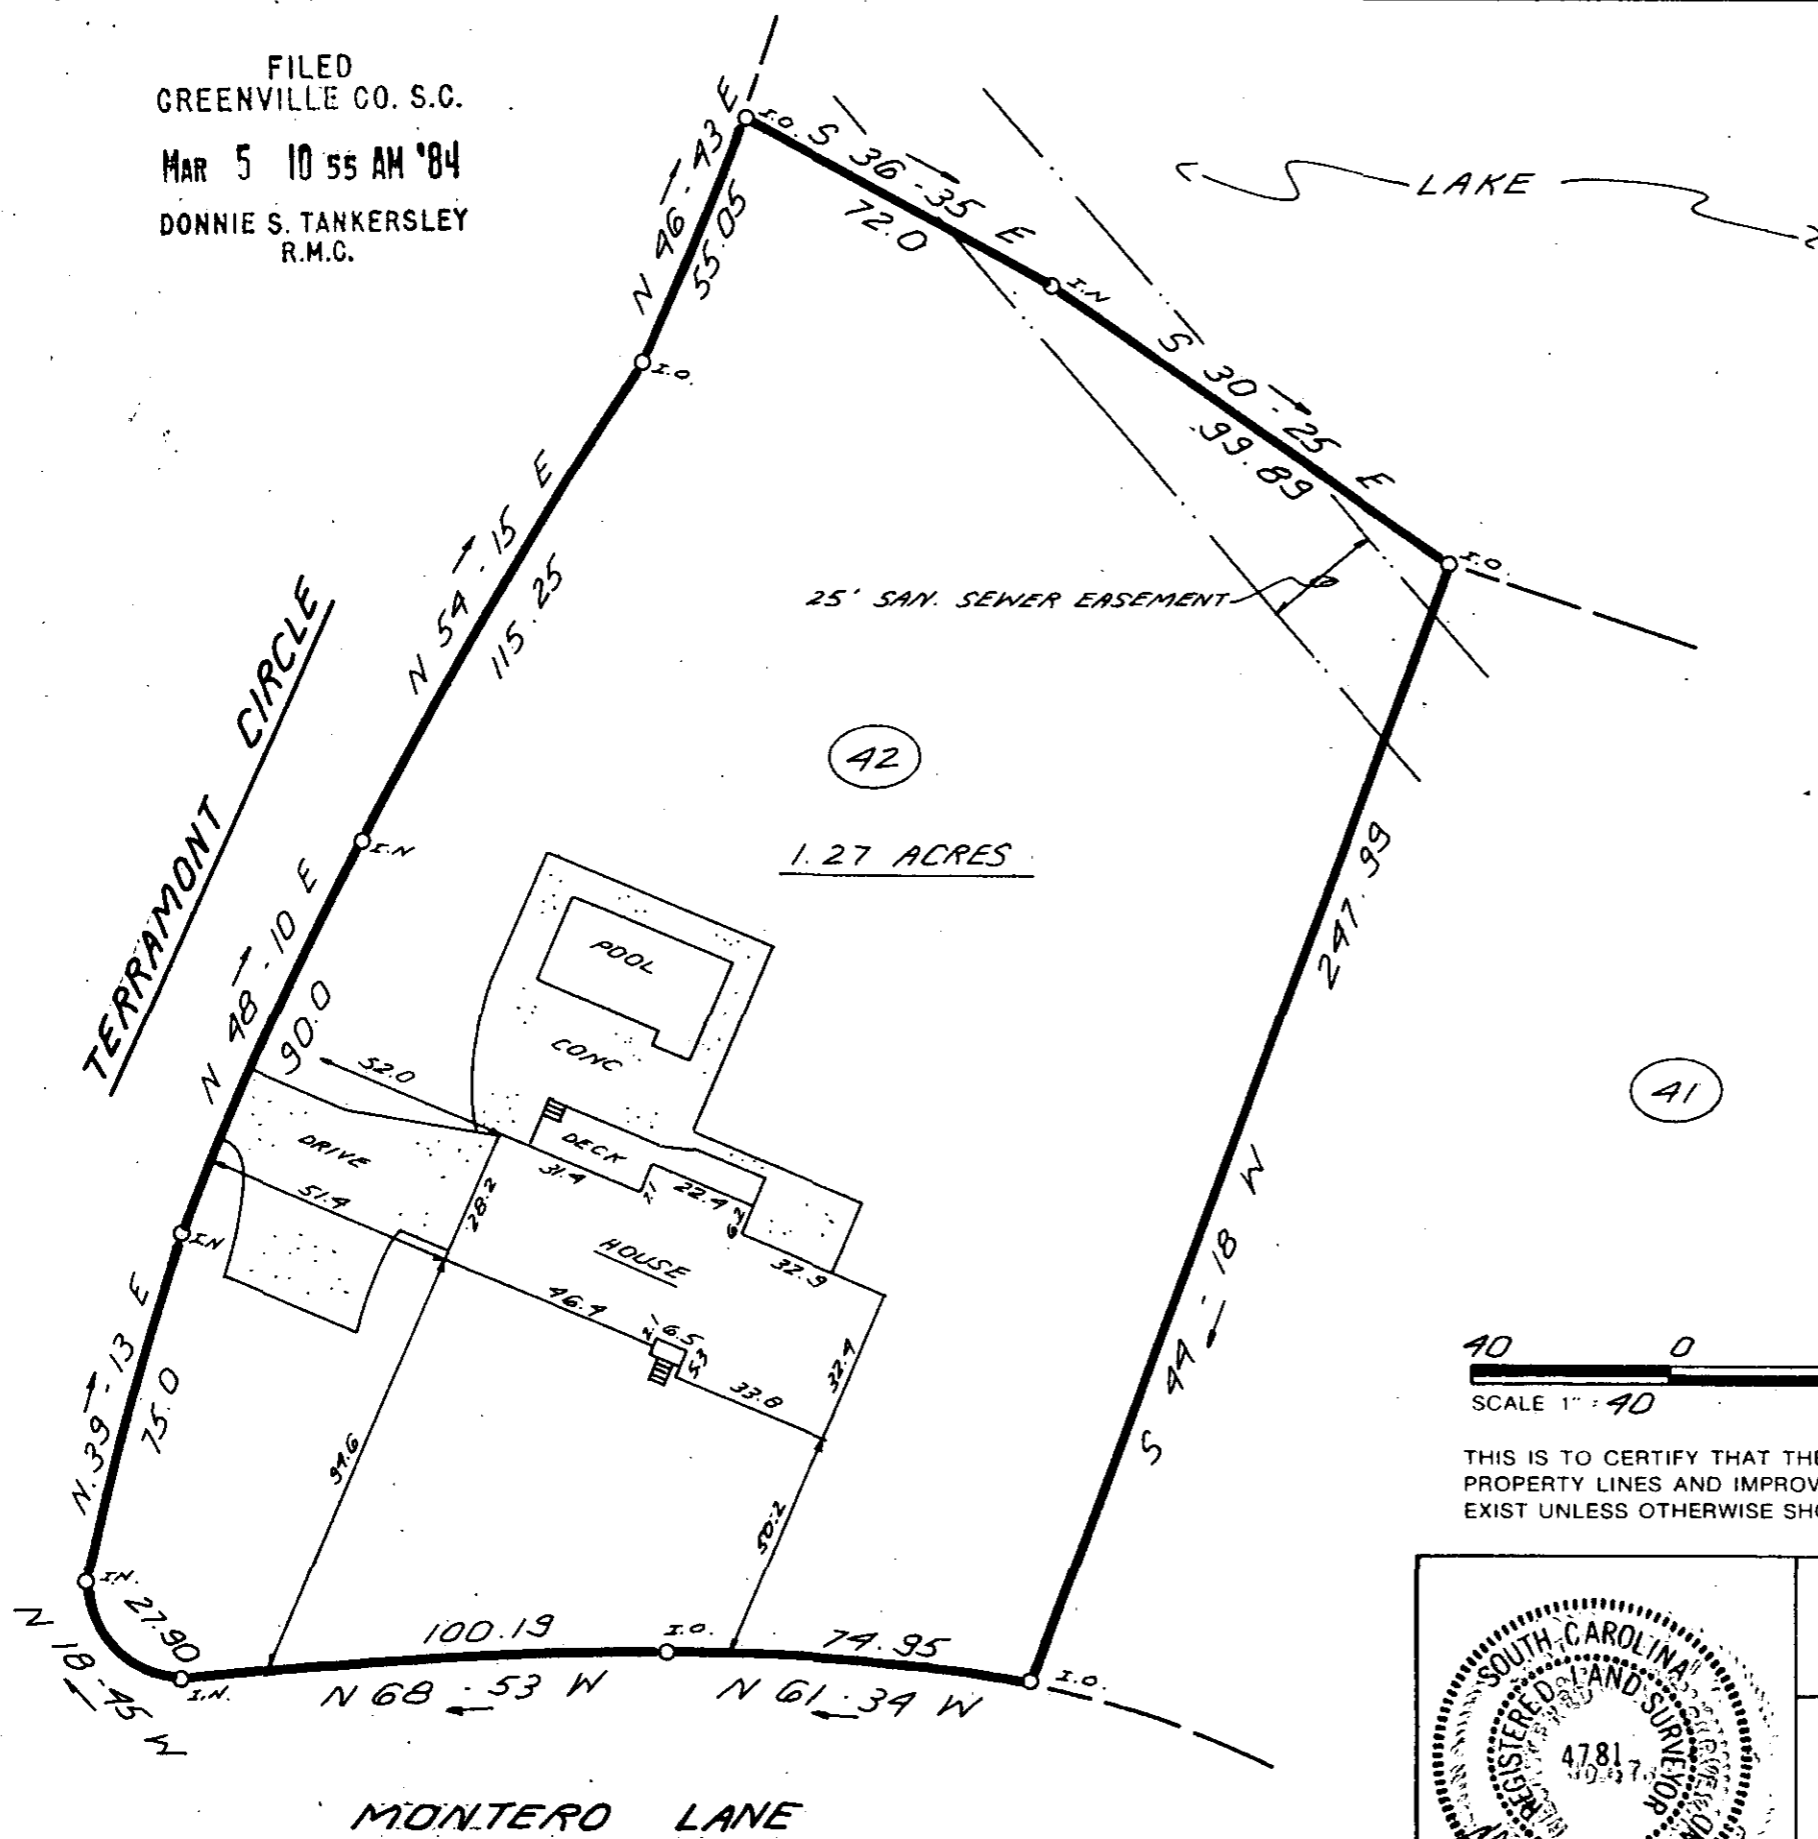


THIS IS TO CERTIFY THAT THE PROPERTY SHOWN ON THIS PLAT WAS SURVEYED UNDER MY DIRECT SUPERVISION. PROPERTY LINES AND IMPROVEMENTS SHOWN ARE LOCATED CORRECTLY AND THAT NO VISIBLE ENCROACHMENTS EXIST UNLESS OTHERWISE SHOWN. THIS PROPERTY IS NOT LOCATED IN A DESIGNATED FLOOD HAZARD AREA.

27181

10-I-29

MAR 5 1984

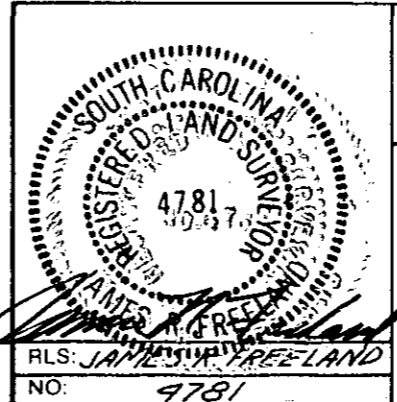

**STATE OF SOUTH CAROLINA
 GREENVILLE COUNTY**

TERRA PINES ESTATES
LOT 42
PROPERTY OF
JOSEPH RICHARD REMPE

FREELAND & ASSOCIATES Engineers • Land Surveyors 318 WEST STONE AVENUE. GREENVILLE, S.C. (803) 271-4924	
PLAT BOOK	PPP-18 E 19
DEED BOOK	1076-290
TAX MAP	538.1-1-151
PARTY CHIEF	M.L.C.
DRAWN	K.E.G.
DATE	MARCH 1, 1984
DWG. NO.	10638

THE PRINT MACHINE, INC. N41289

MICROFILMED