


Note: This Lot # 68 White Oak Hills, Section III, Plat Book 7X - Page 56. There is A 5' Drainage & Utility Easement Along All Side & Rear Lot Lines.

58
Bobby J. Jones Builders, Inc.

57
Bobby J. Jones Builders, Inc.

56

67
Bobby J. Jones Builders, Inc.
Greenville, SC 29601
101 Travis Ave
Village at Park
WICHOLTS & WILCHERT III

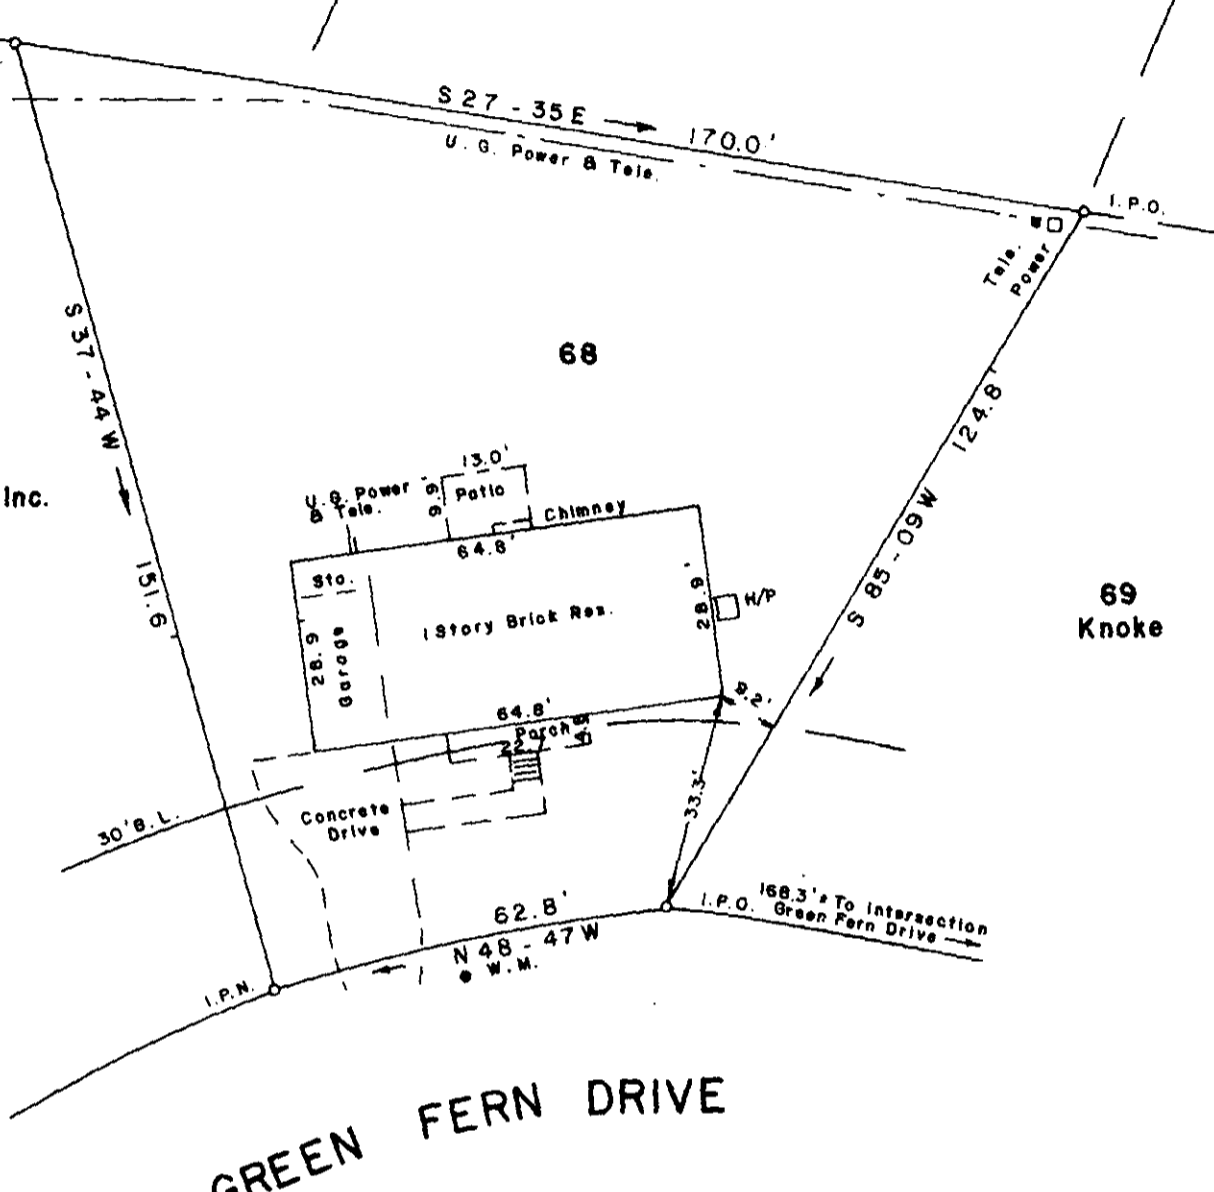

69
Knoke

SURVEY FOR
JAMES A. SAMPSON
PATRICIA M. SAMPSON
NEAR BEREASOUTH GREENVILLE COUNTY
CAROLINA
MARCH 5, 1984

FILED
GREENVILLE CO. S.C.
MAR 15 10 51 AM 1984
DONNIE S. JANKERSLEY
R.M.C.

To The Best Of My Knowledge This Structure Is Not In An Established Flood Zone.

MAR 15 1984 28387

I Hereby Certify That The Measurements As Shown Above Are Correct And There Are No Encroachments Or Projections Other Than Shown.

I Hereby Certify That The Ratio Of Precision Of The Field Survey Is 1/5000 As Shown Hereon And The Area Was Determined By Computer

JEFFERY M. PLUMBLEE, INC.
LAND SURVEYING

10-I-43

Scale 1" = 30'
P.L.S. #7881