

FILED
GREENVILLE CO. S.C.
JUL 26 11 33 AM '84
DONALD S. BRIDGES
SURVEYOR

PERRY D. MASTERS


S 89.35 E
1293.97'

24.99 AC

JAMES W. MOORE
BILLY H. SMITH

JAMES B. FOY


MC KITTRICK ROAD

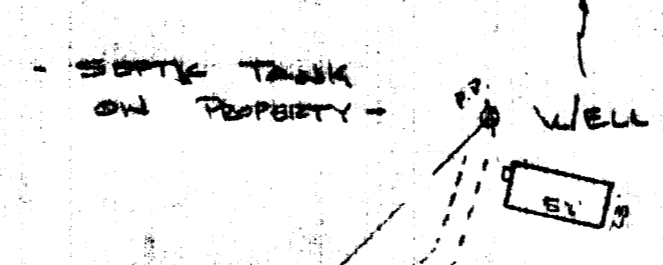

10-T-20

JUL 26 1984 2891

PROPERTY OF
PATRICIA A. FULLER
NEAR GREENVILLE, GREENVILLE COUNTY, S.C.
SCALE 1" = 100'
19 JULY 1984

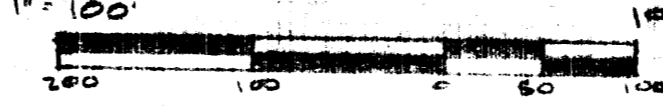

This is to certify that on the 19th day of July, 1984, I surveyed the property shown on this plat, being known as 24.99 acres on plat of PROPERTY OF RUSSELL FULLER and recorded in the BMC Office Greenville County, S. C., in Plat Book "4-1" at Page 181 and also known as PROPERTY OF PATRICIA A. FULLER and recorded in Plat Book at Page ; and that the property lines, walls and buildings are as shown hereon, and that the walls and buildings located on said lot do not encroach or project on adjacent street or property, and that no adjacent walls or buildings encroach or project on said premises, and no power lines cross this property except as shown hereon.

Note: Improvements on this lot are not in a flood hazard area.

R. B. BRIDGES
R. B. BRIDGES, RLS # 1872



CAROLINA SURVEYING Co.
112 MANLY ST.
GREENVILLE, S.C.

Recon Plat