


FILED
GREENVILLE CO. S.C.
OCT 1 12 36 PM '84

FAIRVIEW STREET (S.E. 4th)
WATER & SEWER IN ST. 21/4

SUNSET COURT

U.S. 90A

Note:
Improvements on
this lot are not
in a flood hazard
area.

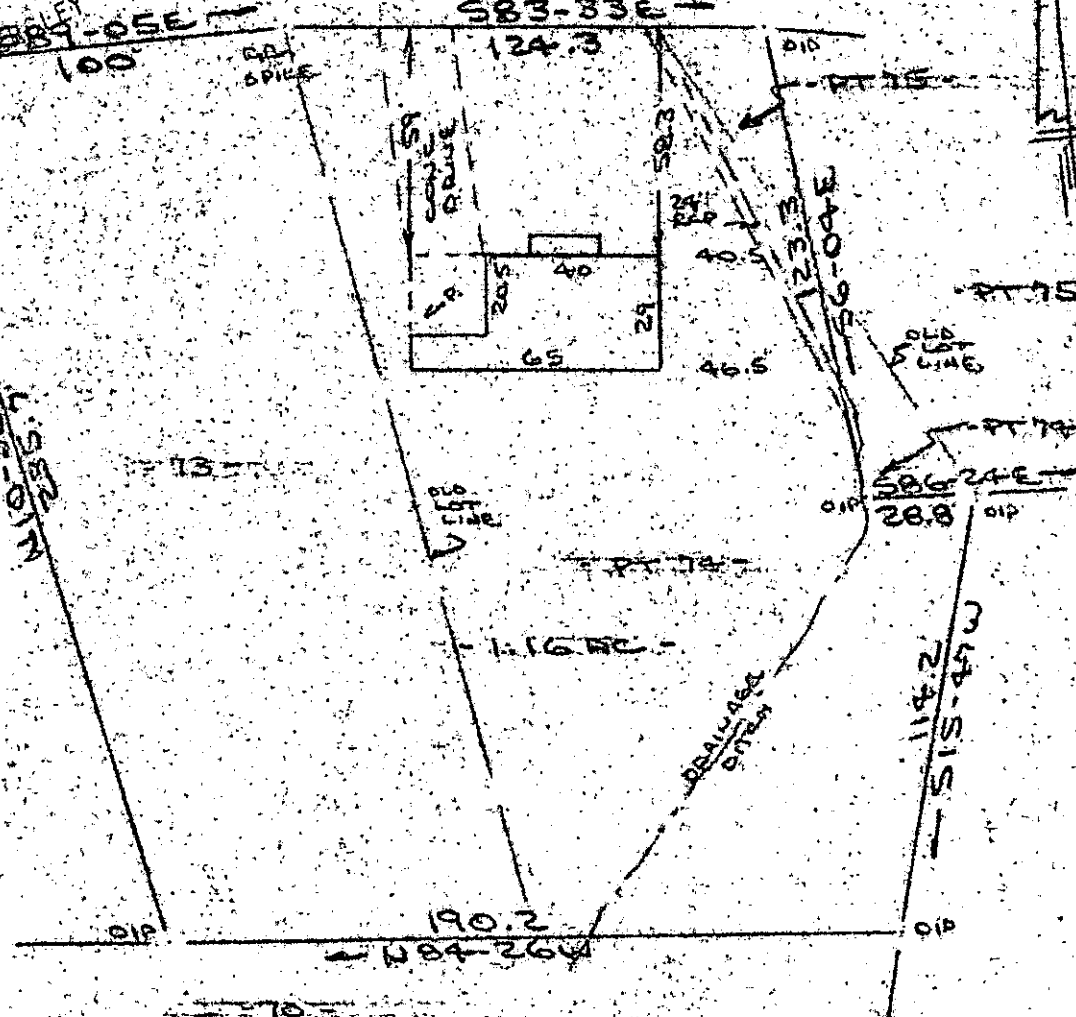

PROPERTY OF
JOE G. GREER & LINDA K. GREER
FOUNTAIN INN GREENVILLE COUNTY, S.C.
SCALE: 1"=50' 27 SEPT 1984



This is to certify that on the 27th day of September, 1984, I surveyed the property shown on this plat, being known as lot 73 & pt. 74 and part of lot 75 on plat of SUNSET HEIGHTS and recorded in the REC. Office Greenville Co., S. C., in Plat Book CO @ Pages 314 - 317 also DEED OF JOE G. GREER & LINDA K. GREER and recorded in Plat Book at Page ; and that the property lines, walls and buildings are as shown hereon, and that the walls and buildings located on said lot do not encroach or project on adjacent street or property, and that no adjacent walls or buildings encroach or project on said premises, and no power lines cross this property except as shown hereon.

OCT 1 1984

10031
10Y-63

INDEX:
Joe G. Greer and Linda K. Greer
709 Fairview Street
Fountain Inn, SC 29644

CAROLINA SURVEYING CO.
112 Early St.
Greenville, S. C.

Recordable Plat
SOUTH CAROLINA
RECORDS & CLERK
OCT 1984
8-B

100-3-101