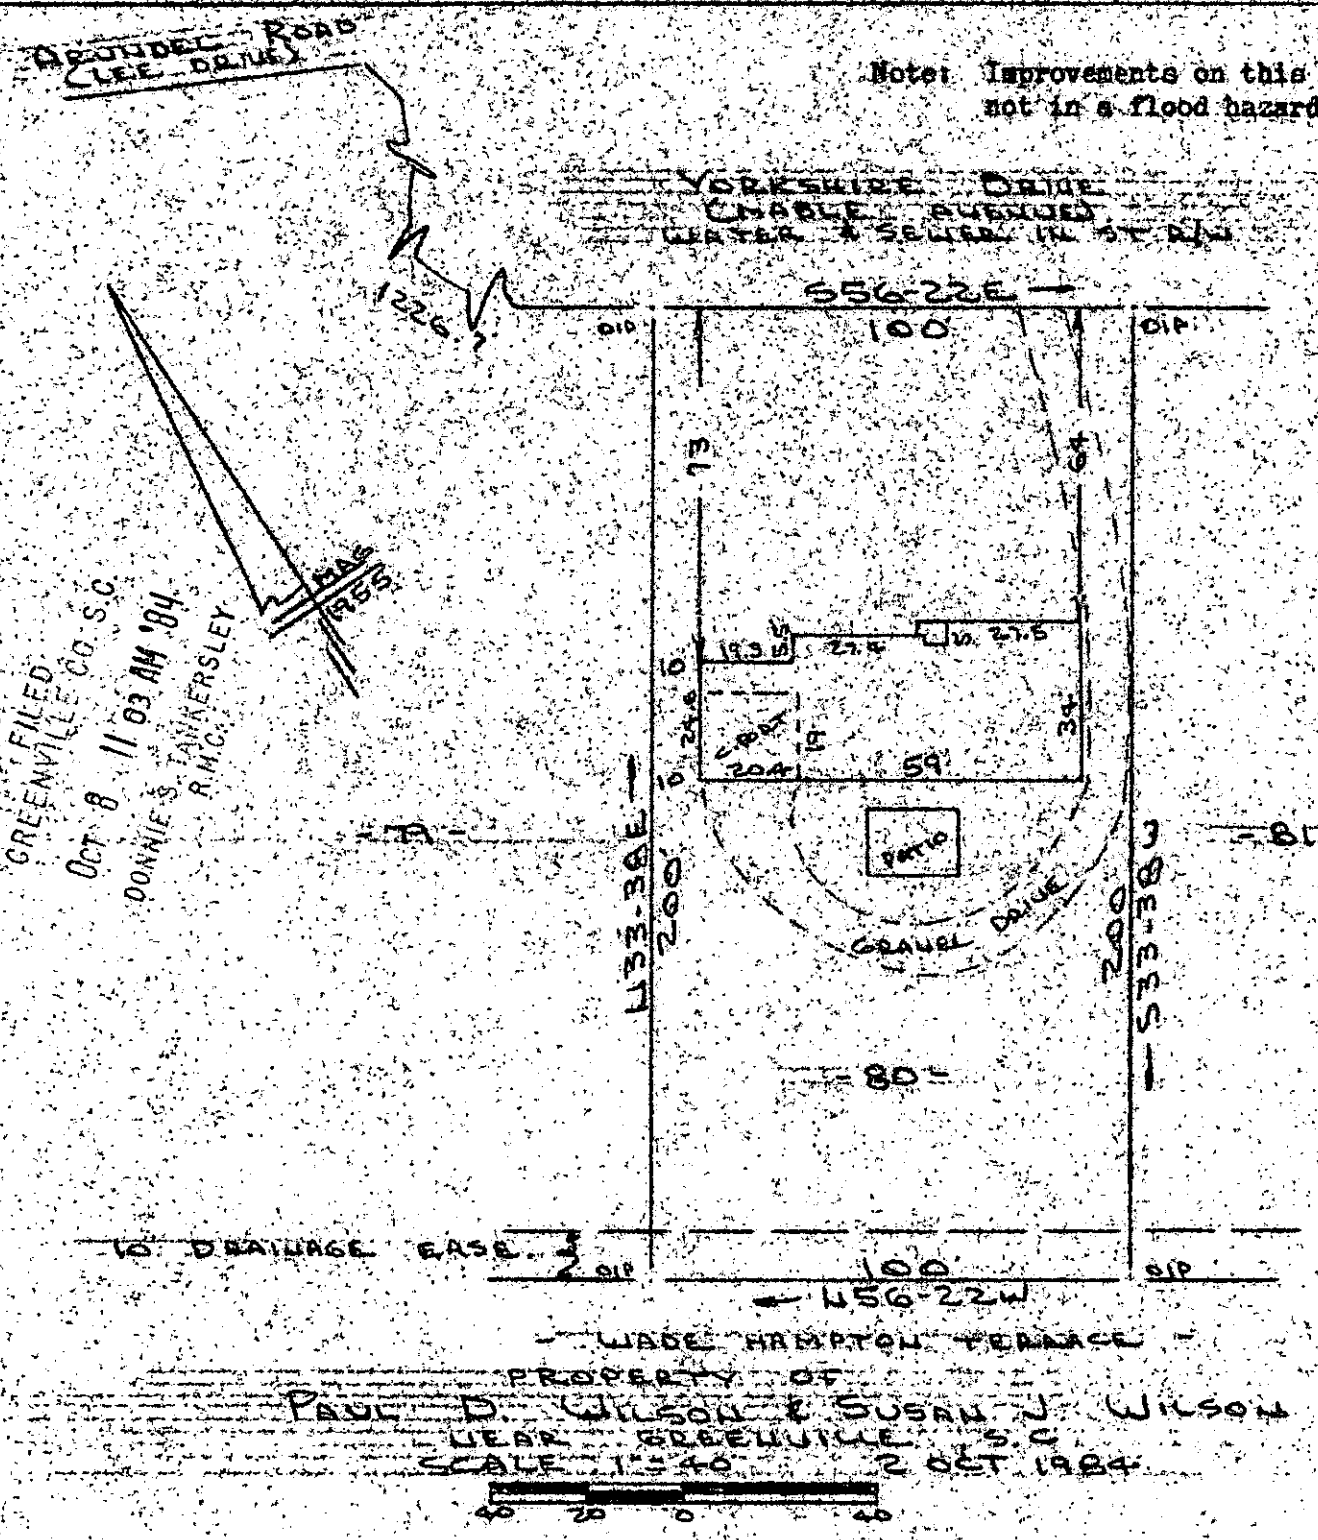

This is to certify that on the 2nd day of October, 1984, I surveyed the property shown on this plat, being known as lot 80 on plat of PLAT NO. 2 OF JAMES H. EDWARDS and recorded in the RMC Office Greenville County, S. C., in Plat Book " II " at Page 120; and that the property lines, walls and buildings are as shown hereon, and that the walls and buildings located on said lot do not encroach or project on adjacent street or property, and that no adjacent walls or buildings encroach or project on said premises, and no power lines cross this property except as shown hereon.

10-4-83 10675

OCT 8 1984

R. B. Bruce, RLS # 1952

CAROLINA SURVEYING CO.
112 Manly St.
Greenville, S. C.

OCT 8 84

Recordable Plat