MICROFILMED

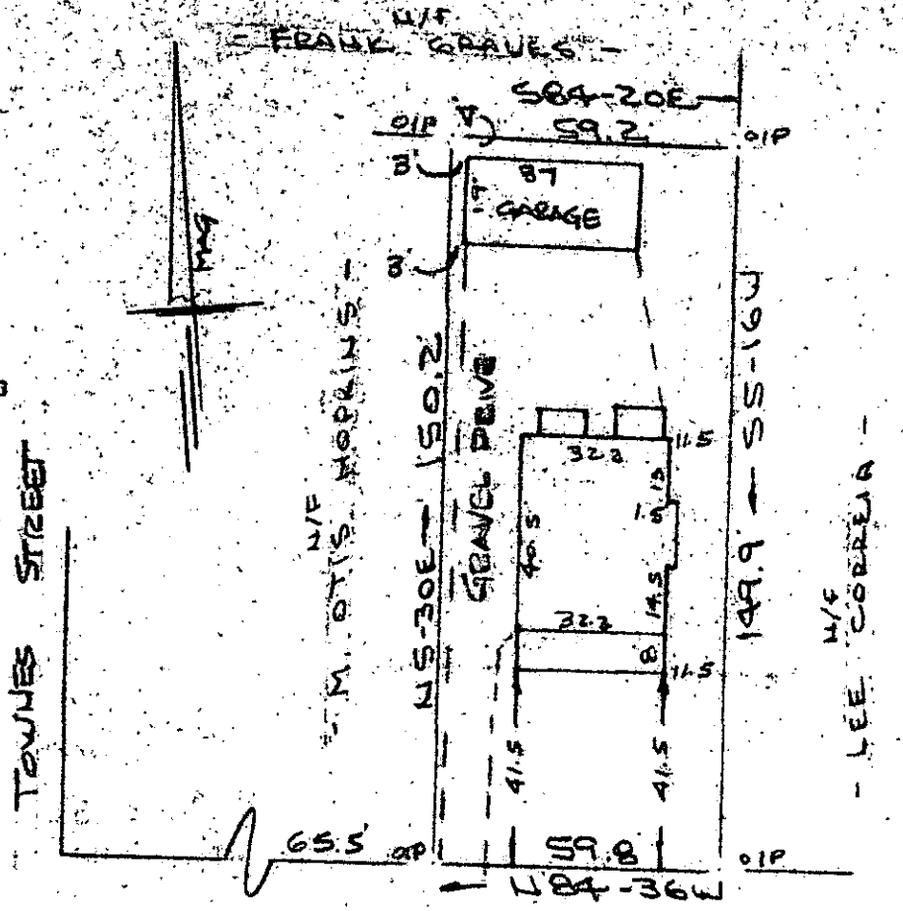

Note:
Improvements on this lot are not in a flood hazard area.

FILED
GREENVILLE CO. S.C.
OCT 8 11 31 AM '84
DONNIE S. TANKERSLEY
R.M.C.

W. STONE AVE
WATER & SEWER IN ST R/W
PROPERTY OF
STEVEN D. BICHEL
CITY OF GREENVILLE, GREENVILLE CO., S.C.
SCALE 1" = 40'
4 OCT 1984

80 40 0 80 40

This is to certify that on the 4th day of October, 1984, I surveyed the property shown on this plat, being known as PROPERTY OF STEVEN D. BICHEL and recorded in the RMC Office Greenville County, S. C., in Plat Book at Page ; and that the property lines, walls and buildings are as shown hereon, and that the walls and buildings located on lot do not encroach or project on adjacent street or property, and that no adjacent walls or buildings encroach or project on said premises, and no power lines cross this property except as shown hereon.

10676

10-Y-84

OCT 8 1984

R. B. Bruce, RLS #1952

SOUTH CAROLINA REGISTERED 1952 LAND SURVEYOR R. B. BRUCE

CAROLINA SURVEYING CO.
112 Manly St.
Greenville, S. C.

Recordable Plat

3.00CI

275/55

5-4-11