

MICROFILMED

FILED  
GREENVILLE CO. S.C.  
- PEACE-HAGOOD ASSOC. -

OCT 19 2 33 PM '84

DONNIE S. YANKERSLEY  
R.M.C.


N63-24E  
89.49

25' SAN SEWER  
R/W

- 8918 # -

- MARIA N/E. CARTER -

175.4 TOT  
138-50W  
83.52

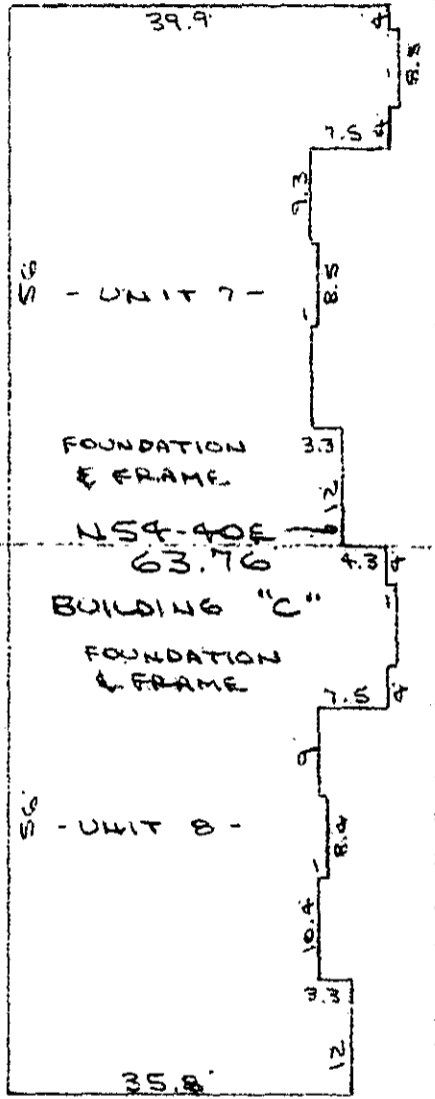

Note:  
Improvements on this lot  
are not in a flood  
hazard area.

160.39'  
535-50E

- PEACE-HAGOOD ASSOC. -

AUGUSTA STREET

59.14  
79.14 TOT - 553-52W


350.26

11966 ✓

MILLS AVENUE (BUSINESS HWY 29)  
WATER & SEWER IN RD R/W

11A-29

PROPERTY OF  
PEACE - HAGOOD ASSOCIATES  
GREENVILLE COUNTY, GREENVILLE, S.C.  
SCALE: 1"=20' 27 SEPT 1984

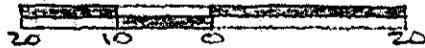

This is to certify that on the 27th day of September, 1984, I surveyed the property shown on this plat, being known as Unit 7 & Unit 8 on plat of MILLS MEDICAL CENTER and recorded in the RMC Office, Greenville County, S. C., in Plat Book "10 - M" at Page 23; and that the property lines, walls, and buildings are as shown hereon, and that the walls and buildings located on said lot do not encroach or project on adjacent street or property, and that no adjacent walls or buildings encroach or project on said premises, and no power lines cross this property except as shown hereon.

Recordable Plat - 3 OCT 1984

R. B. Bruce, RLS # 1952

CAROLINA SURVEYING CO., 112 Manly St., Greenville, S. C.

262/45A

96-5-PT14