


MICROFILMED

FILED
GREENVILLE CO. S.C.
NOV 14 1984
DONNIE S. TANKERSLEY
R.M.C.

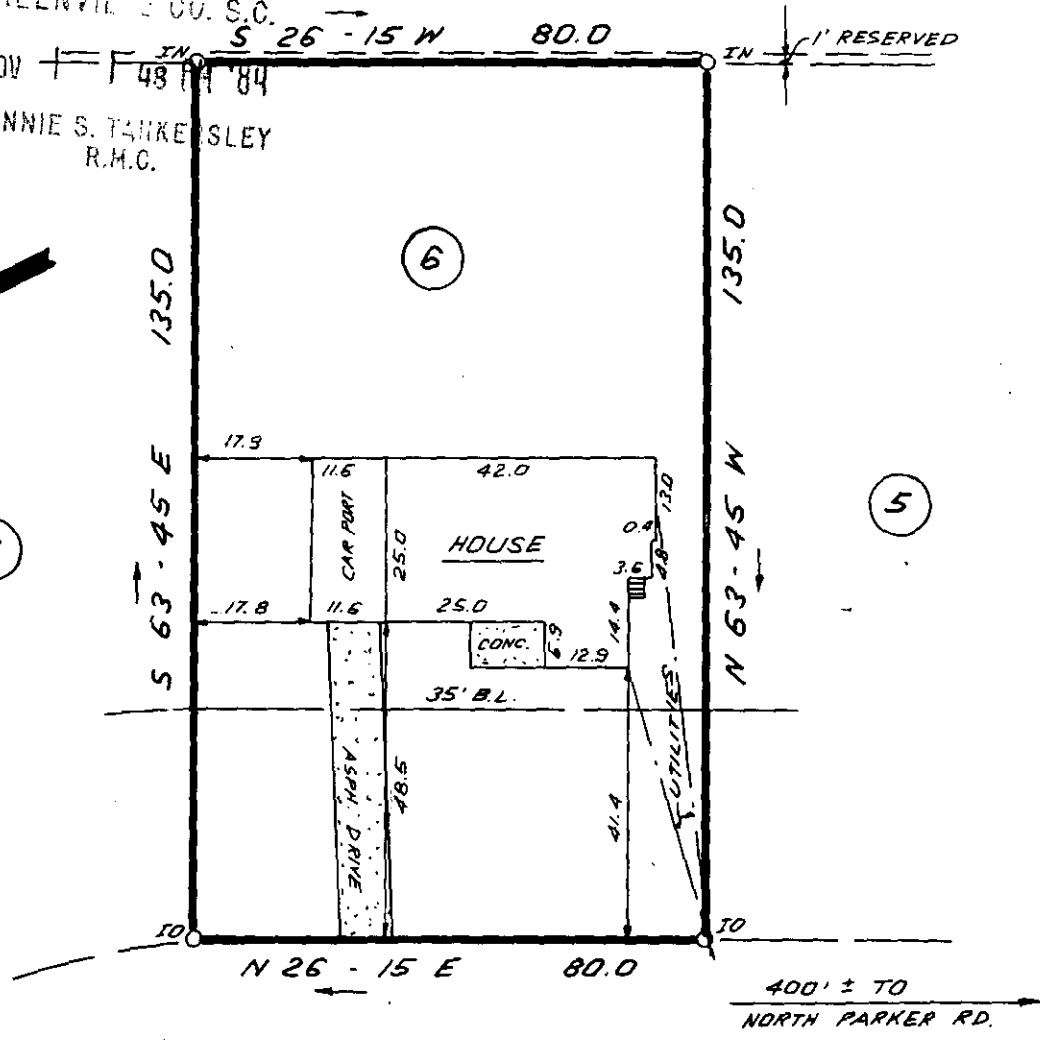


MAULDIN CIRCLE

NOV 1 1984

11A-84 ✓
13358



THIS IS TO CERTIFY THAT THE PROPERTY SHOWN ON THIS PLAT WAS SURVEYED UNDER MY DIRECT SUPERVISION PROPERTY LINES AND IMPROVEMENTS SHOWN ARE LOCATED CORRECTLY AND THAT NO VISIBLE ENCROACHMENTS EXIST UNLESS OTHERWISE SHOWN. THIS PROPERTY IS NOT LOCATED IN A DESIGNATED FLOOD HAZARD AREA

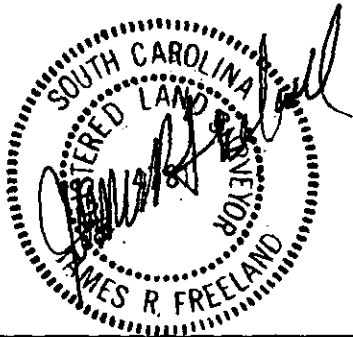

RLS JAMES R. FREELAND
NO. 4781

**STATE OF SOUTH CAROLINA
GREENVILLE COUNTY**

MAULDIN MEADOWS
LOT 6
PROPERTY OF
RANDY H. BOATRIGHT
JENNY G. BOATRIGHT

FREELAND & ASSOCIATES
Engineers • Land Surveyors
318 WEST STONE AVENUE.
GREENVILLE, S.C.
(803) 271-4924

PLAT BOOK	EE - 151
DEED BOOK	1127-606
TAX MAP	453-1-20
PARTY CHIEF	L.T. 3.0001
DRAWN	I.R.
DATE	10-31-84
DWG NO	11994

KA