


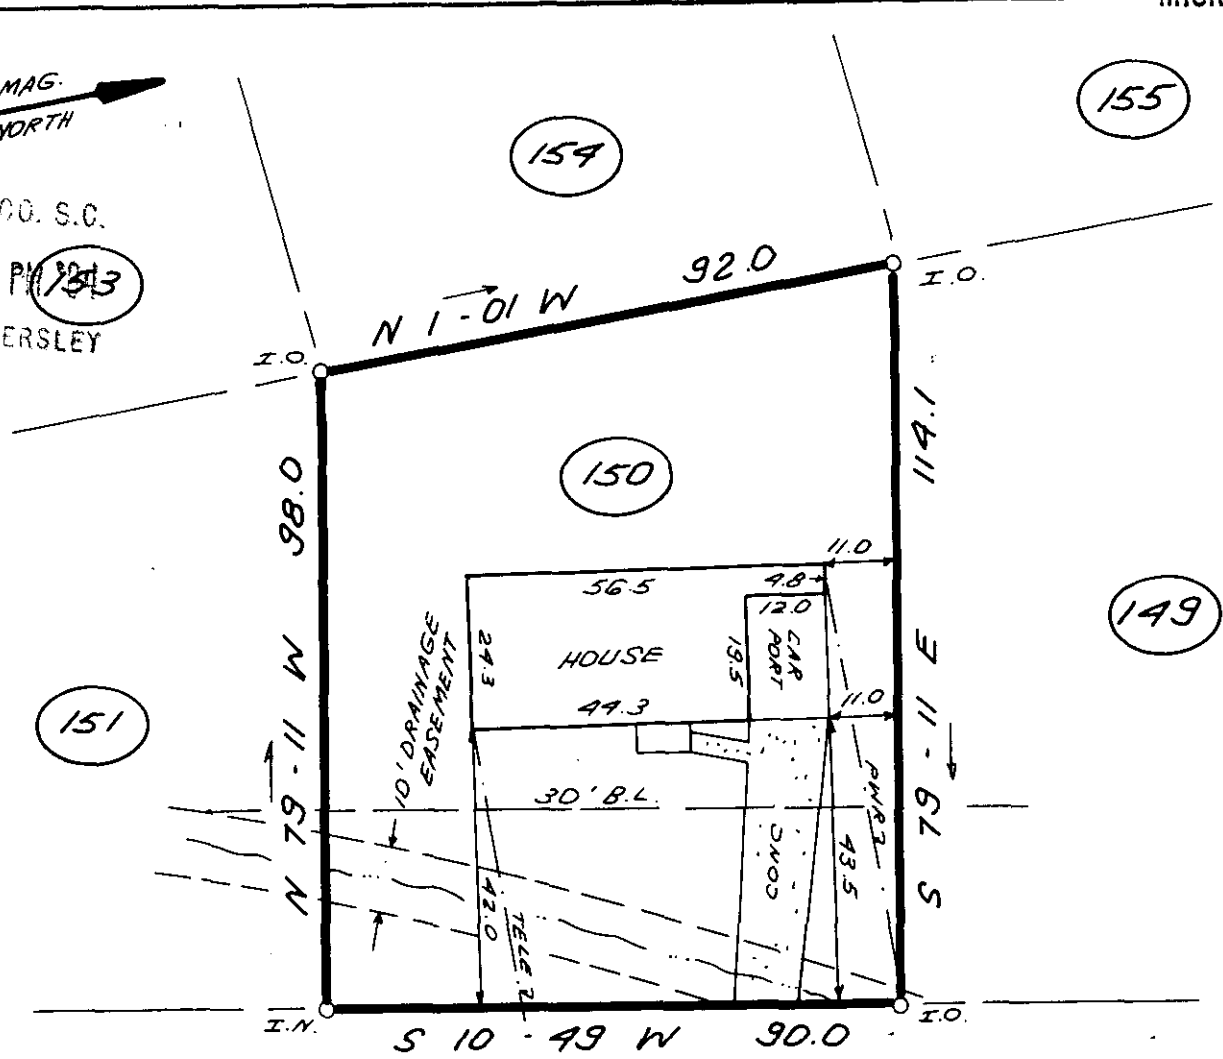


FILED
GREENVILLE CO. S.C.
NOV 6 4 27 PM 1984
DONALD S. TANNERSLEY
R.M.C.



355' ± TO
WEST CASTLE RD.


FLOWER DRIVE

NOV 6 1984
13883
11-A-99

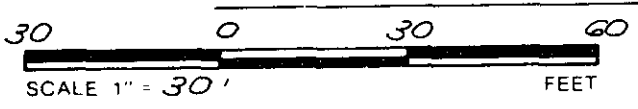

NOTE:
THERE IS A 5' EASEMENT ALONG
ALL REAR & SIDE LOT LINES FOR
DRAINAGE & UTILITIES.

THIS IS TO CERTIFY THAT THE PROPERTY SHOWN ON THIS PLAT WAS SURVEYED UNDER MY DIRECT SUPERVISION
PROPERTY LINES AND IMPROVEMENTS SHOWN ARE LOCATED CORRECTLY AND THAT NO VISIBLE ENCROACHMENTS
EXIST UNLESS OTHERWISE SHOWN THIS PROPERTY IS NOT LOCATED IN A DESIGNATED FLOOD HAZARD AREA

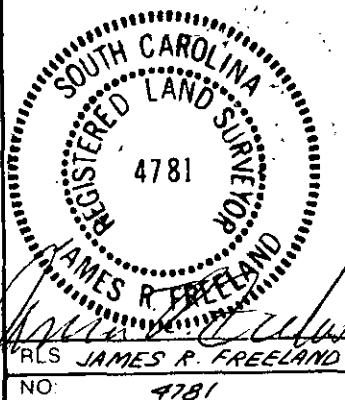

**STATE OF SOUTH CAROLINA
GREENVILLE COUNTY**

PINE HILL VILLAGE
LOT 150
PROPERTY OF
FURMAN MAKINS
NELL J. MAKINS

FREELAND & ASSOCIATES
Engineers • Land Surveyors
318 WEST STONE AVENUE.
GREENVILLE, S.C.
(803) 271-4924

PLAT BOOK	QQ - 168
DEED BOOK	909 - 647
TAX MAP	WG 2.5 - 1-152
PARTY CHIEF	J.C.
DRAWN	K.E.G.
DATE	OCT. 30, 1984
DWG NO	11985

2 NOV 6 1984

3.000