


FILED
GREENVILLE CO. S.C.

DEC 21 4 11 PM '84

DONNIE S. TANKERSLEY



MAP NO. 9 SUGAR CREEK

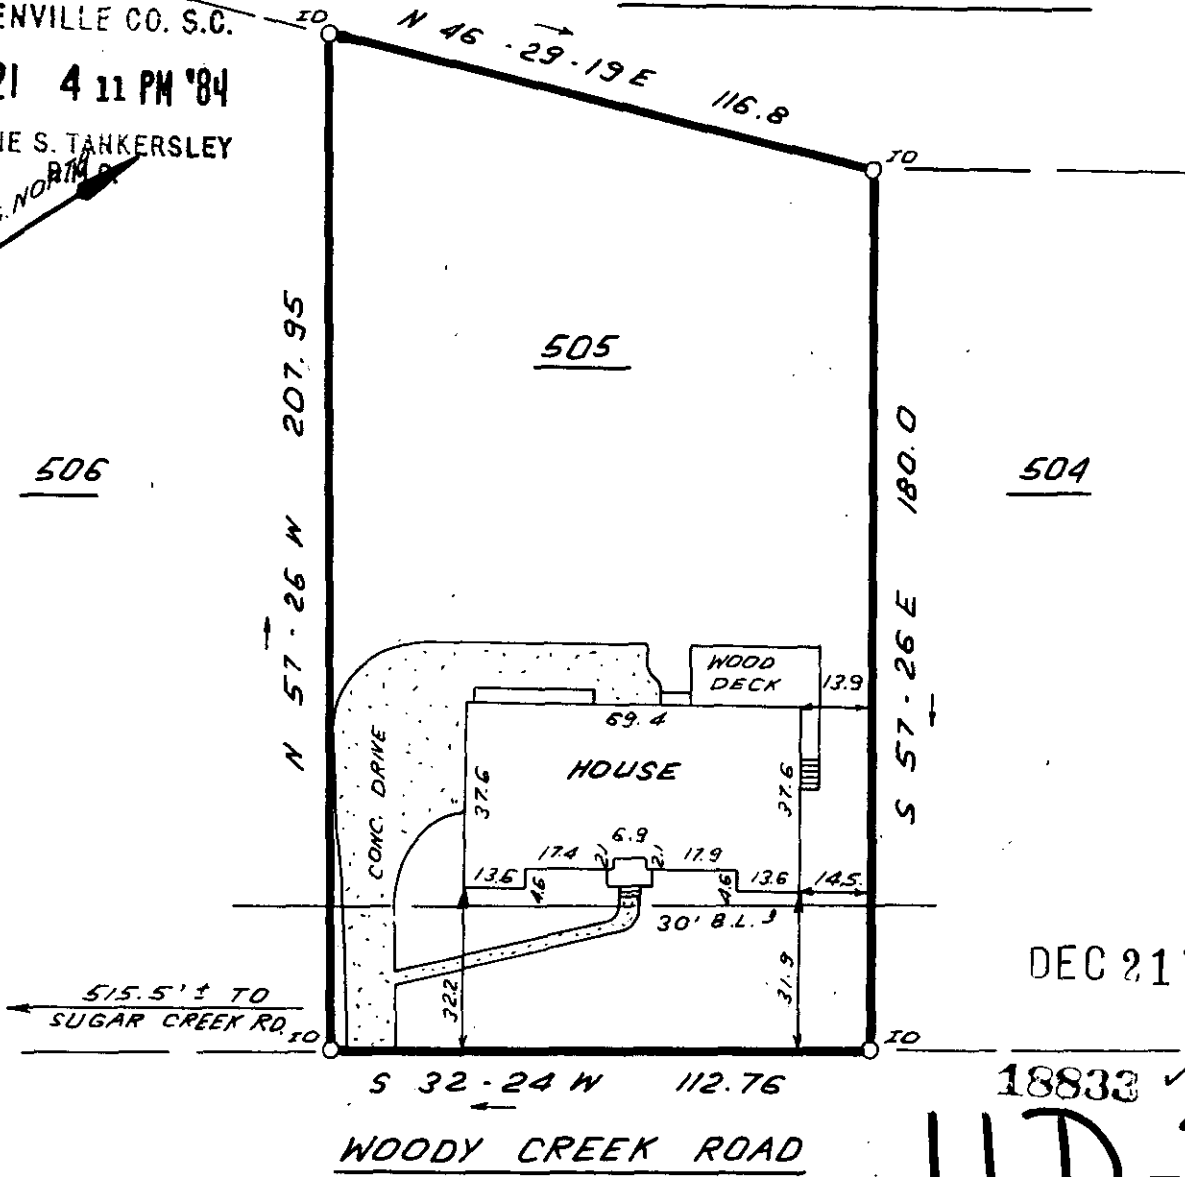

DEC 21 1984

18833 ✓

11D-71



NOTE: 5' DRAINAGE & UTILITY EASEMENT EACH SIDE OF ALL SIDE & REAR LOT LINES.

THIS IS TO CERTIFY THAT THE PROPERTY, SHOWN ON THIS PLAT WAS SURVEYED UNDER MY DIRECT SUPERVISION. PROPERTY LINES AND IMPROVEMENTS SHOWN ARE LOCATED CORRECTLY AND THAT NO VISIBLE ENCROACHMENTS EXIST UNLESS OTHERWISE SHOWN. THIS PROPERTY IS NOT LOCATED IN A DESIGNATED FLOOD HAZARD AREA

2 DE 21 84 893

STATE OF SOUTH CAROLINA
GREENVILLE COUNTY

SUGAR CREEK
MAP 1, SEC. 2, LOT 505
PROPERTY OF
RANDAL H. HOLCOMBE
NANCY C. HOLCOMBE

FREELAND & ASSOCIATES
Engineers • Land Surveyors
318 WEST STONE AVENUE.
GREENVILLE, S.C.
(803) 271-4924

PLAT BOOK	7C - 68
DEED BOOK	
TAX MAP	534.6-1-105
PARTY CHIEF	R.A.J.
DRAWN	I.R.
DATE	12-17-84
DWG NO	12,235

RLS JAMES R. FREELAND
NO: 4781

