




FILED
GREENVILLE CO. S.C.
DEC 31 12 13 PM '84
DONNIE S. TANKERSLEY
R.M.C.

DEC 31 1984


11-D-94

19510

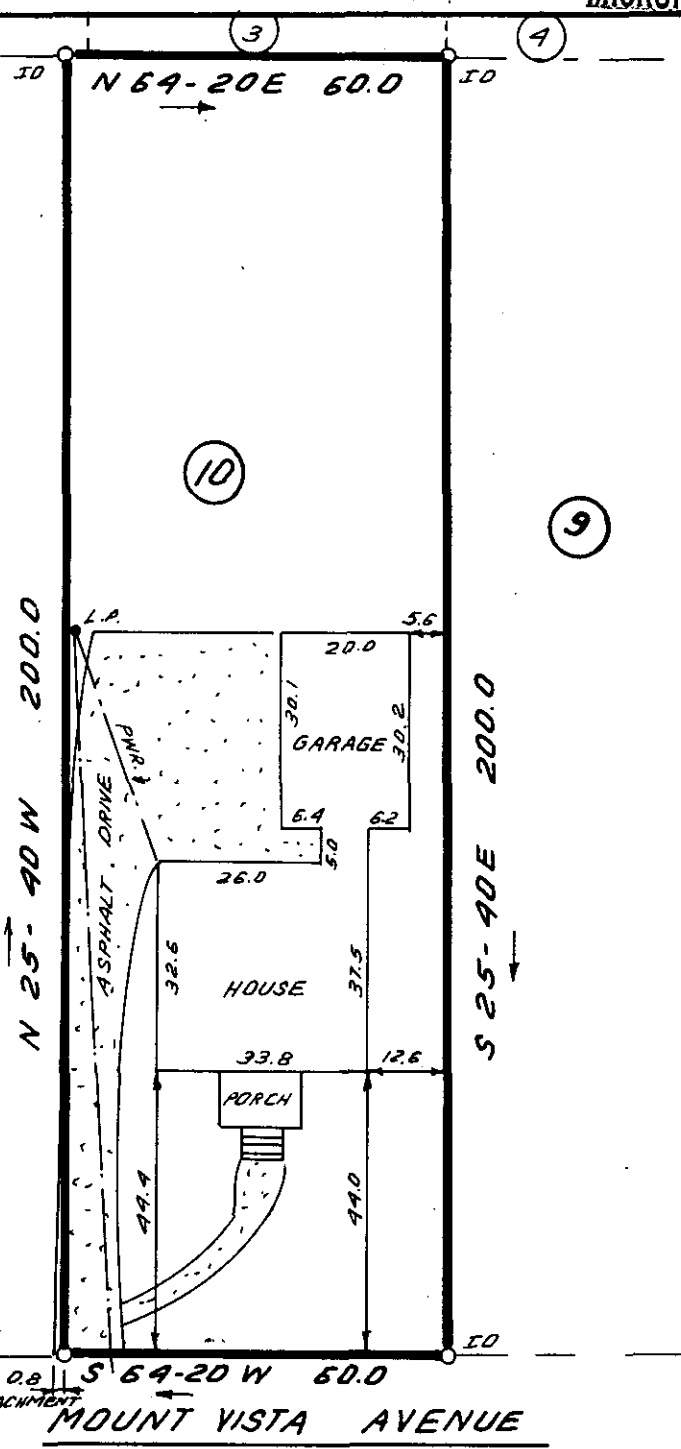

SCALE: 1" = 30 FEET

THIS IS TO CERTIFY THAT THE PROPERTY SHOWN ON THIS PLAT WAS SURVEYED UNDER MY DIRECT SUPERVISION. PROPERTY LINES AND IMPROVEMENTS SHOWN ARE LOCATED CORRECTLY AND THAT NO VISIBLE ENCROACHMENTS EXIST UNLESS OTHERWISE SHOWN. THIS PROPERTY IS NOT LOCATED IN A DESIGNATED FLOOD HAZARD AREA

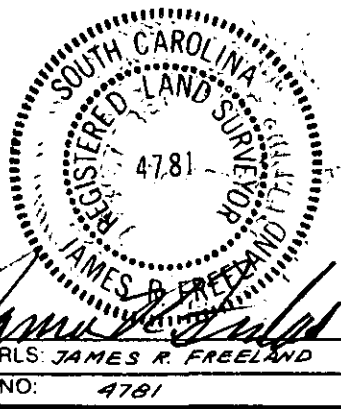

STATE OF SOUTH CAROLINA
GREENVILLE COUNTY

CARABEL C. MARTIN PROP.
LOT 10
PROPERTY OF
PHILLIP ARTHUR KILGORE
ALINE CREWS KILGORE

FREELAND & ASSOCIATES
Engineers • Land Surveyors
318 WEST STONE AVENUE.
GREENVILLE, S.C.
(803) 271-4924

PLAT BOOK	J-73
DEED BOOK	957-596
TAX MAP	205-4-8
PARTY CHIEF	JEC
DRAWN	BR
DATE	12-21-84
DWG. NO.	12,253