

FILED
GREENVILLE CO., S.C.
FEB 4 9 47 AM '85
DONNIE S. LANKERSLEY
R.M.C.

- 1 -
- 3.59 AC -


POWER LOCAL SERVICE

- TO BE SEPTIC TANK ON LOT -

899.5
- 175-35-170

D. L. RAY
631.6-1-7

PROPERTY OF
WALTER E. STEELER
ONEAL TOWNSHIP, GREENVILLE CO., S.C.
SCALE: 1"=100' 28 JAN 1985

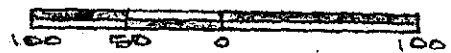

GCTO 1 FEB 04 85

Note: Improvements on this lot are not in a flood hazard area.

Note: 5' drainage easement & utility easement along all side & rear lot lines.

024

This is to certify that on the 28th day of January, 1985, I surveyed the property shown on this plat being known as lot 1 (3.59 acres) on plat of CAIN ACRES and recorded in the RMC Office Greenville County, S.C., in plat book 8 -P Page 17; and that the property lines, walls and buildings are as shown hereon, and that the walls and buildings located on said lot do not encroach or project on adjacent street or property, and that no adjacent walls or buildings encroach or project on said premises, and no power lines cross this property except as shown hereon.

FEB 4 1985

11-H-10

22966

R. B. Bruce
R. B. Bruce, RLS # 1952

FEB 4 1985

3.00CD

CAROLINA SURVEYING CO. 112 Manly St. Greenville S.C.

Recordable Plat

SURVEYOR
BRUCE (7096)

MICROFILMED