


Note: Improvements on this lot are not in a flood hazard area.

Note: There is a 10' drainage & utility easement along all side & rear lot lines.

FILED
GREENVILLE CO. S.C.
FEB 5 8 32 AM '85
DONNIE S. TANKERSLEY
R.M.C.

PROPERTY OF
RYAN D. HENDLEY & MINDY M. HENDLEY

GREENVILLE, S.C.
SCALE: 1"=50' FEB 1985

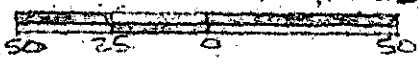

This is to certify that on the 1st day of February, 1985, I surveyed the property shown on this plat, being known as lot 45 on plat of SECTION THREE STONE LAKE HEIGHTS and recorded in RMC Office Greenville County, S. C., in Plat Book "QQ" at Page 96; and that the property lines, walls and buildings are as shown hereon, and that the walls and buildings located on said lot do not encroach or project on adjacent street or property, and that no adjacent walls or buildings encroach or project on said premises, and no power lines cross this property except as shown hereon. Also being known as PROPERTY OF RYAN D. HENDLEY & MINDY M. HENDLEY and recorded in Plat Book at Page 23137 ✓

11-4-14

FEB 5 1985

R. B. Brice
R. B. Brice, RLS # 1952

Recordable Plat

CAROLINA SURVEYING CO.
112 Early St., Greenville, S.C. 29601