MICROFILMED

REF: DEED BOOK 1142 @ PAGE 508-510 FOR STRIP FROM CITY OF G'VILLE.

NOTE: PLAT REV. 21 JAN 1985 TO SHOW SIDEWALK LOCATION IN RELATION TO IMPROVEMENTS

FILED
GREENVILLE CO. S.C.

FEB 5 4 24 PM '85

DONNIE S. TANKERSLEY
R.M.C.

MAR 1981

Note: Improvements on this lot are not in a flood hazard area.

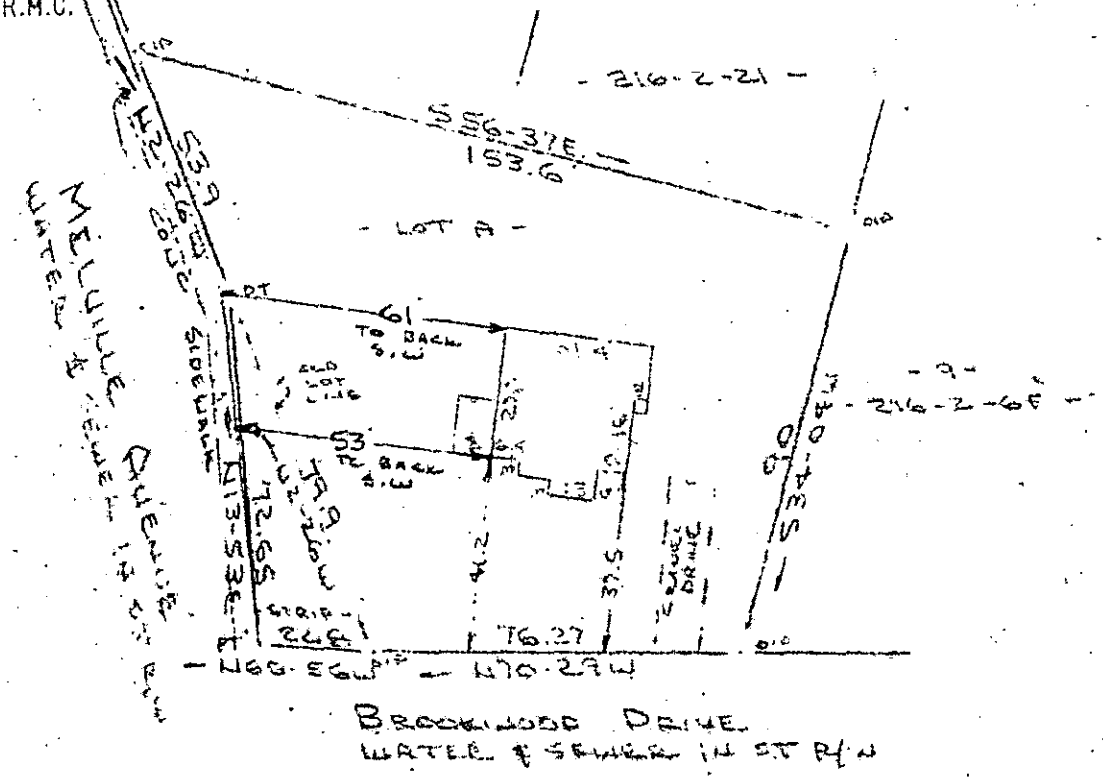

PROPERTY OF
DEBORAH K. PALANZA
GREENVILLE, S.C.
SCALE: 1" = 40' 11 DEC 1984

This is to certify that on the 17th day of December, 1984, I surveyed the property shown on this plat, being known as lot " A " on plat of PROPERTY OF DEBORAH K. PALANZA and recorded in the RMC Office Greenville County, S. C., in Plat Book at Page ; and that the property lines, walls and buildings are as shown hereon, and that the walls and buildings located on said lot do not encroach or project on adjacent street or property, and that no adjacent walls or buildings encroach or project on said premises, and no power lines cross this property except as shown hereon.

FEB 5 1985

11-H-17

23144

R. B. Bruce, RLS # 19

Recordable Plat

CAROLINA SURVEYING CO.
112 Manly St.
Greenville, S. C.

3.00 8 31 B 01

278/46A

216-2-21.1 & 216-2-22.1

19782