MICROFILMED

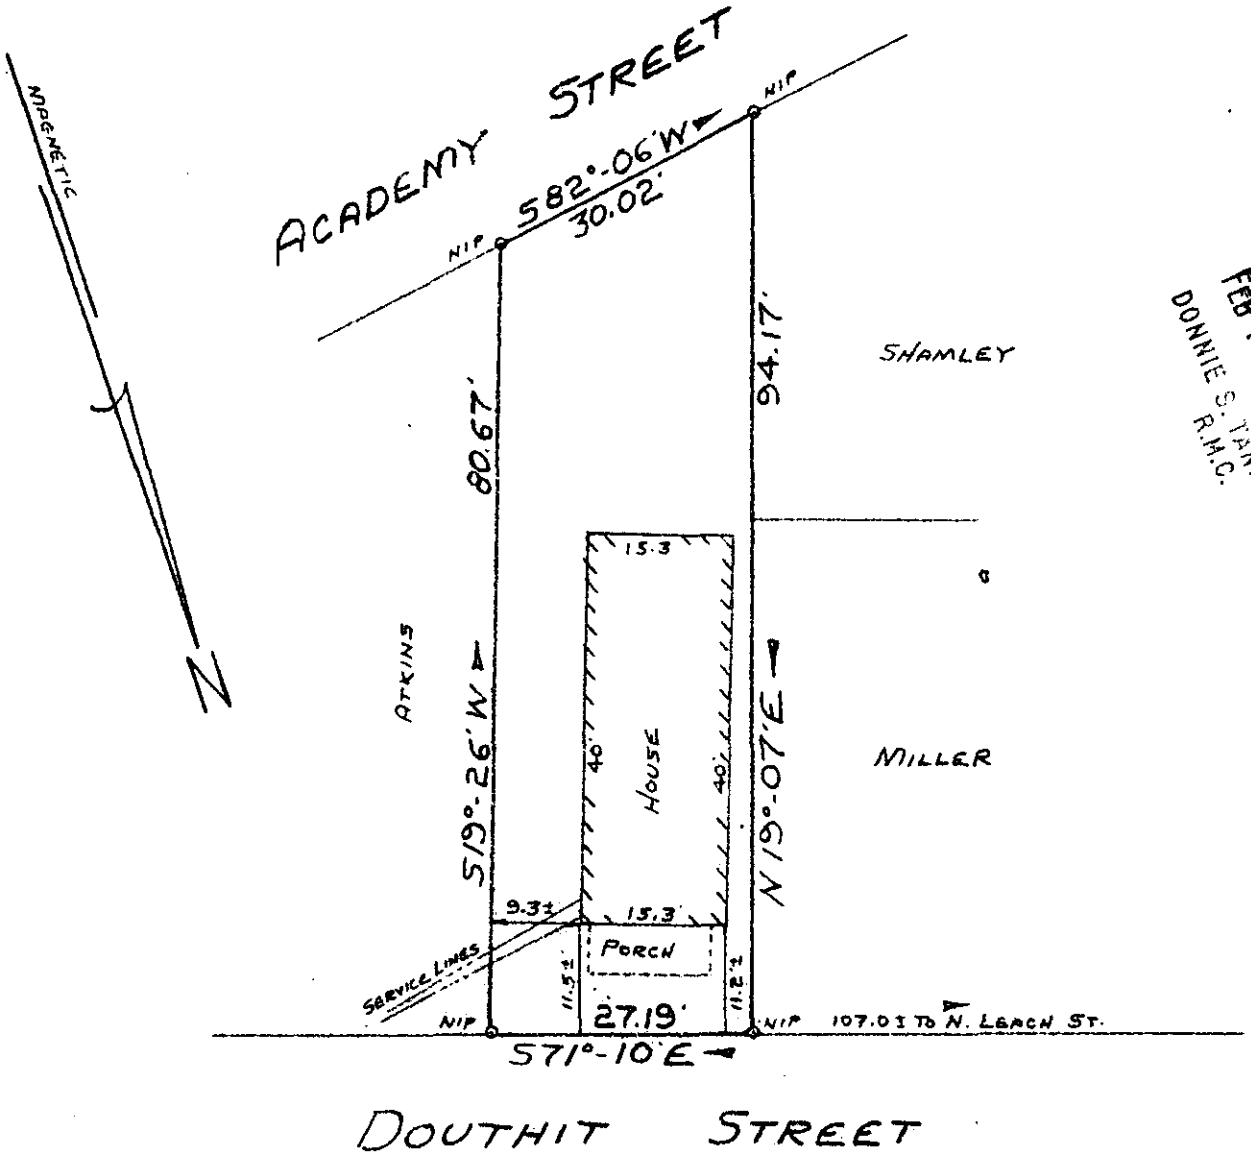

FILED
GREENVILLE CO. S.C.
FEB 12 4 32 PM '85
DONNIE S. TANKERSLEY
R.M.C.

23794

11-H-38

PROPERTY OF

ASBERRY CLIFTON AGNEW

GREENVILLE, GREENVILLE Co., So. CAROLINA

FEB 12 1985

JAN 9, 1985 SCALE 1"=20'

This is to certify that on January 9, 1985, I surveyed the property shown on this plat known as Property of Cliffton Agnew as recorded in the RMC Office for Greenville County in Plat Book at Page , and that the property lines, walls and buildings are as shown hereon, and that the building located on said lot does not project nor encroach on adjacent streets or property, and that no adjacent walls or buildings project nor encroach on said lot, and that no utility lines cross this lot except as may be shown hereon. The degree of accuracy is 1/8,000.

NOTE: This property is not located within a flood hazard area.

References: Tax Map Sheet 78-6-18
Deed Book 28 Page 224

Surveyed by: Richard D. Wooten, Jr.
Greenville, South Carolina

Richard D. Wooten
S. C. R. L. S. No. 4678

Dwg. No. 3625 B