MICROFILMED

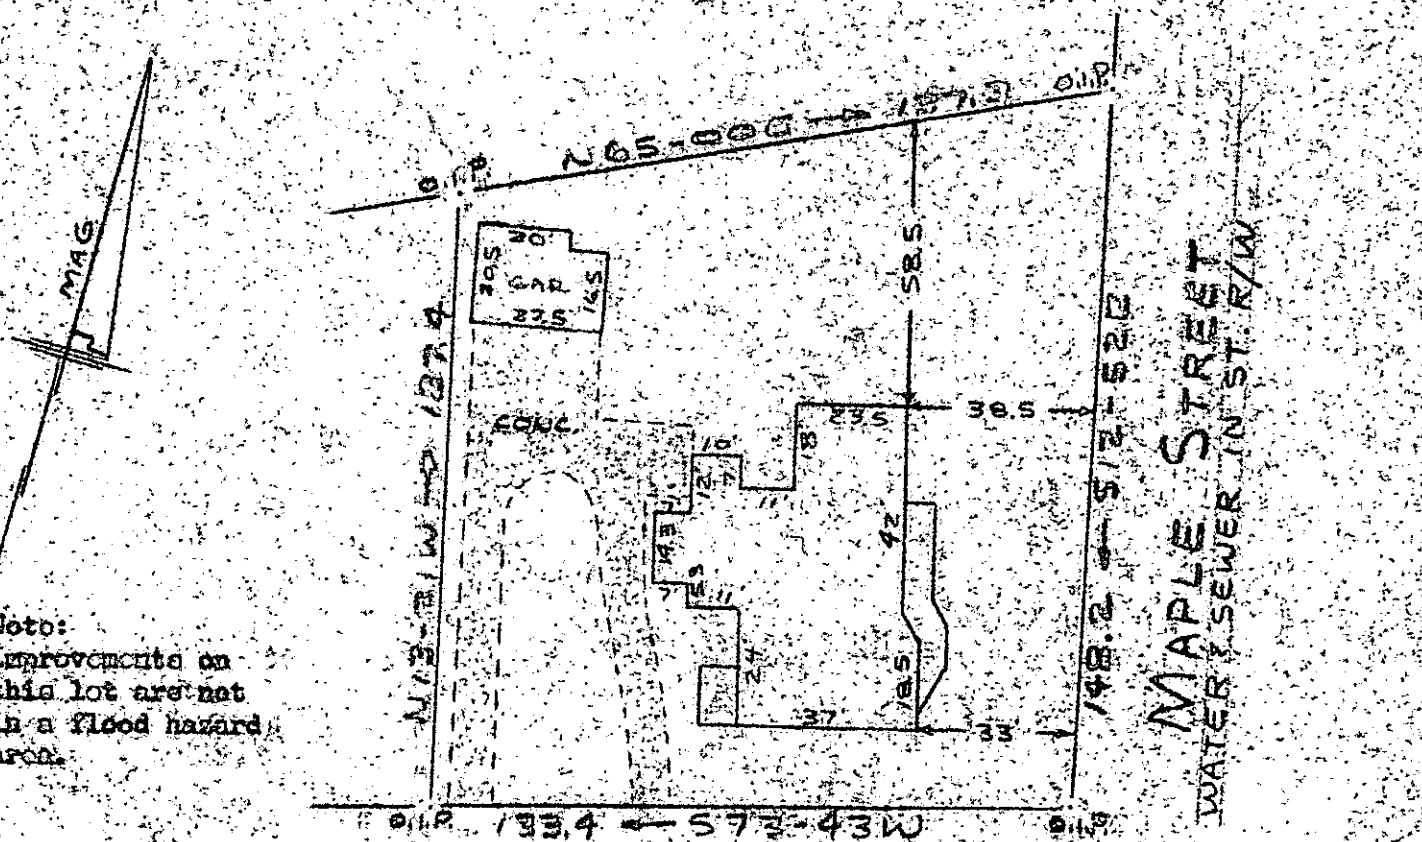

Note:
Improvements on this lot are not in a flood hazard area.

TRADE STREET

PROPERTY OF
HAROLD D. MEADORS & EVELYN L. MEADORS
CITY OF SIMPSONVILLE, S.C.
SCALE: 1" = 40' 29 JAN 1985

40 20 0 40

This is to certify that on the 29th day of January, 1985, I surveyed the property shown on this plat, being known as PROPERTY OF HAROLD D. MEADORS & EVELYN L. MEADORS and recorded in the RMC Office Greenville County, S. C., in Plat Book at Page ; and that the property lines, walls and buildings are as shown hereon, and that the walls and buildings located on said lot do not encroach or project on adjacent street or property, and that no adjacent walls or buildings encroach or project on said premises, and no power lines cross this property except as shown hereon.

11-H-42 ✓ 24010

FEB 14 1985

DONNIE S. TANKERSLEY R.M.C.

FEB 14 3 21 PM '85

FILED GREENVILLE CO. S.C.

R. B. Bruce

R. B. Bruce, RLS # 1952

CAROLINA SURVEYING CO.
112 Manly St.
Greenville, S. C.

Recordable Plat

2 FEB 14 85 S35

3.00 DEED

274/738-74

308-3-5