


FILED  
GREENVILLE CO. S.C.  
FEB 22 4 28 PM '85  
DONNIE S. WILKERSLEY  
R.M.C.


33

34

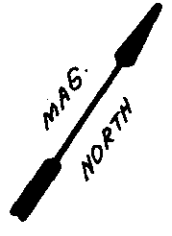

44

42

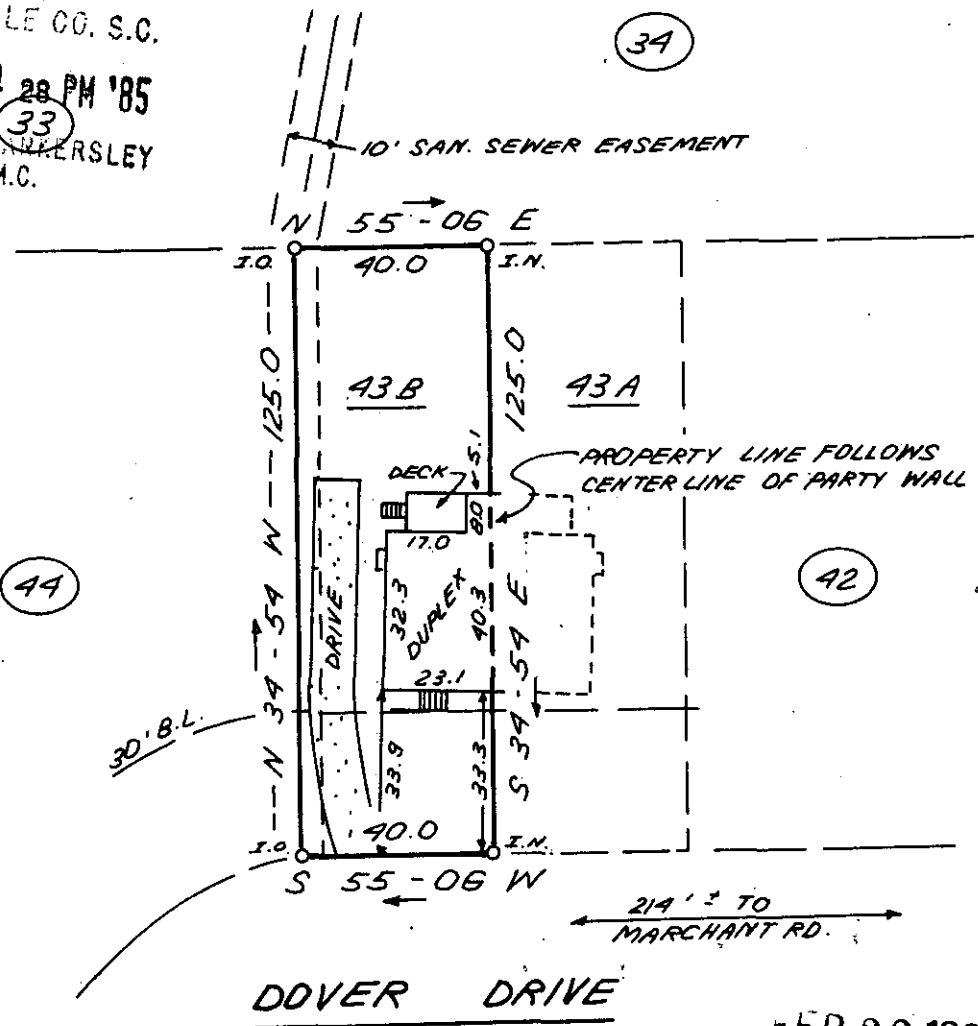

FEB 22 1985

11-H-69

NOTE: 5' DRAINAGE EASEMENT  
ALONG ALL REAR & SIDE LOT LINES



24860

THIS IS TO CERTIFY THAT THE PROPERTY SHOWN ON THIS PLAT WAS SURVEYED UNDER MY DIRECT SUPERVISION. PROPERTY LINES AND IMPROVEMENTS SHOWN ARE LOCATED CORRECTLY AND THAT NO VISIBLE ENCROACHMENTS EXIST UNLESS OTHERWISE SHOWN. THIS PROPERTY IS NOT LOCATED IN A DESIGNATED FLOOD HAZARD AREA.

STATE OF SOUTH CAROLINA  
GREENVILLE COUNTY

FREELAND & ASSOCIATES  
Engineers • Land Surveyors  
318 WEST STONE AVENUE.  
GREENVILLE, S.C.  
(803) 271-4924

CAMBRIDGE PARK  
LOT 43 B  
PROPERTY OF  
JUDITH B. STENHOUSE

PLAT BOOK	4R @ 11
DEED BOOK	1092 - 897
TAX MAP	538.12-1-43
PARTY CHIEF	R.A.J.
DRAWN	K.E.G.
DATE	FEB 22 1985
DWG. NO.	12482

RLS: JAMES R. FREELAND  
NO: 4781