MICROFILMED

Note:
Improvements on this lot are not in a flood hazard area.

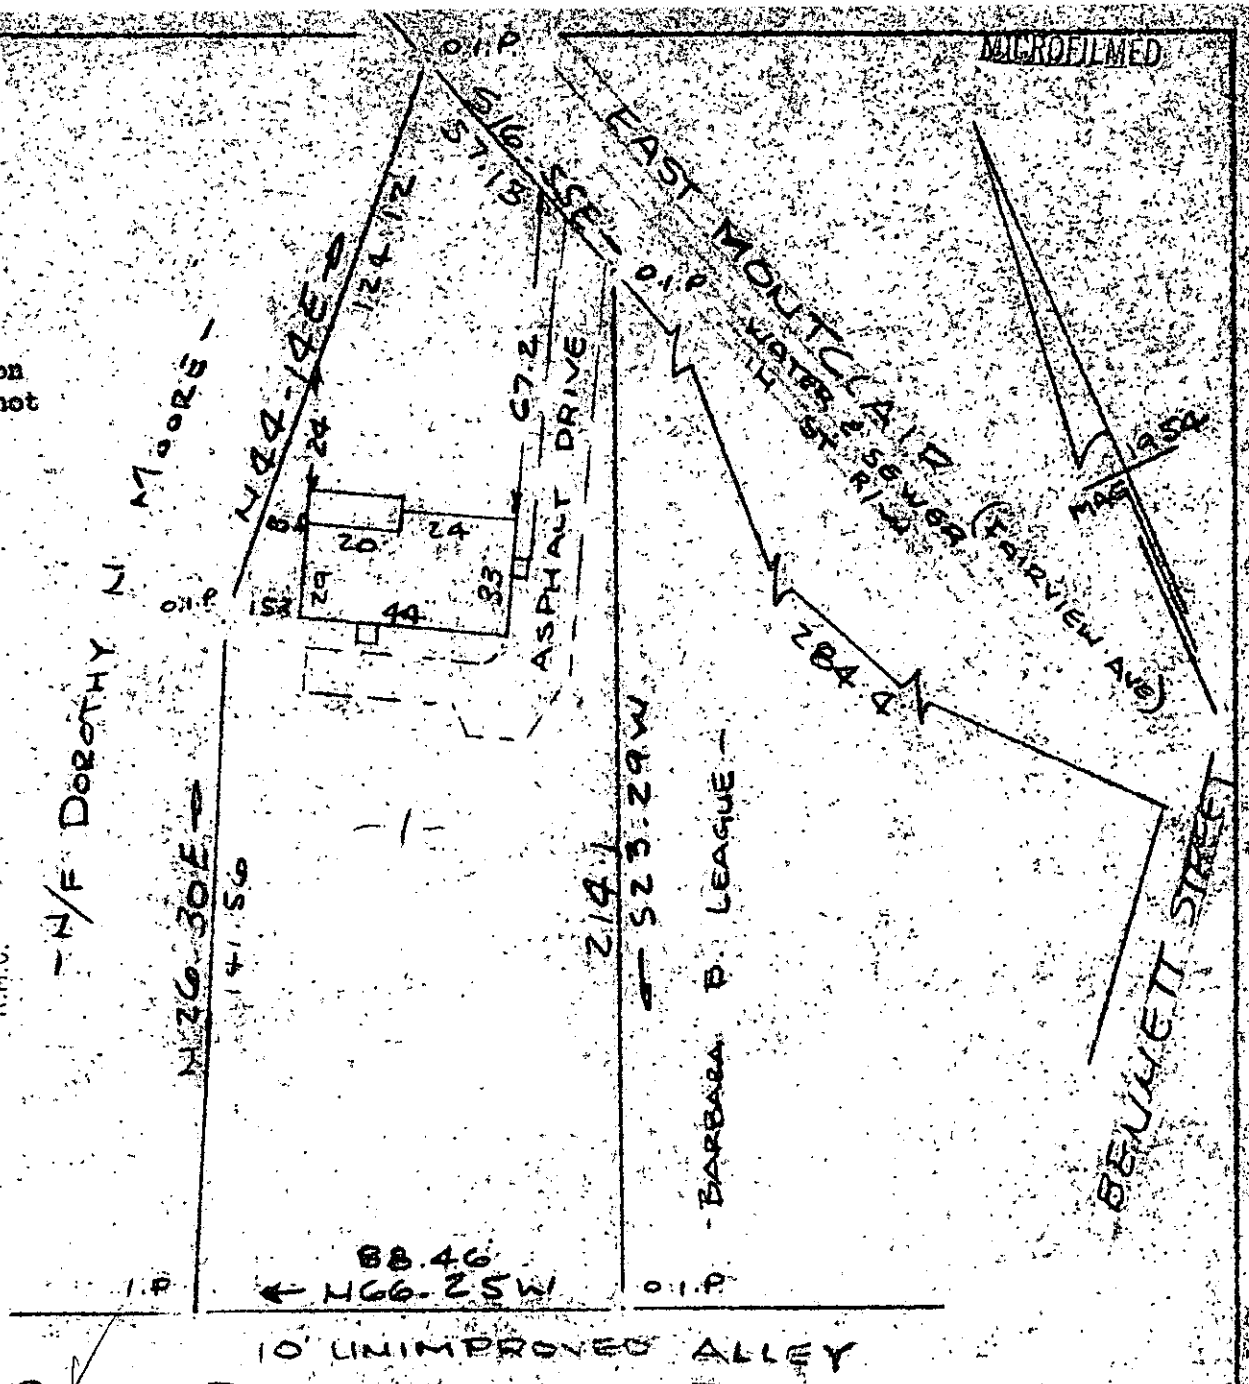

FILED
GREENVILLE CO. S.C.
FEB 27 3 45 PM '85
DONNIE S. TANKERSLEY
R.M.C.

25272

PROPERTY OF
OLIN R. BLANTON & GEORGIA R. THOMPSON
GREENVILLE S.C.
SCALE 1" = 40' 25 FEB 1985

40 20 0 40 80

11-H-83

FEB 27 1985

This is to certify that on the 25th day of February, 1985, I surveyed the property shown on this plat, being known as lot 1 on plat of J. H. HAULDIN and recorded in the RMC Office Greenville County, S. C., in Plat Book " UU " at Page 88 and also known as PROPERTY OF OLIN R. BLANTON & GEORGIA R. THOMPSON and recorded in Plat Book 11-H at Page 83 ; and that the property lines, walls and buildings are as shown hereon, and that the walls and buildings located on said lot do not encroach or project on adjacent street or property, and that no adjacent walls or buildings encroach or project on said premises, and no power lines cross this property, except as shown hereon.

R. B. Bruce
R. B. Bruce, RLS # 1952

CAROLINA SURVEYING CO.
112 Manly St., Greenville, S.C.

FEB 27 85 1243

Recordable Plat

288 / 9A 119-1-14