

JAMES A.K. ROPER N/F


N 66-15-28 W 100.0



756

757

758

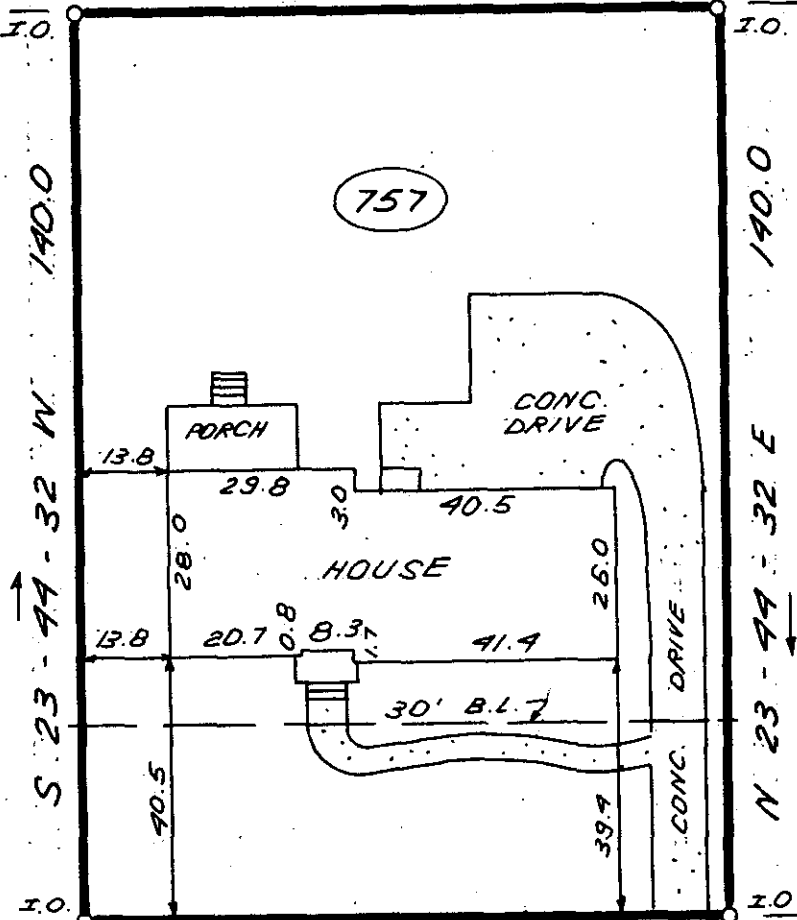

S 66-15-28 E 100.0

352.17 ± TO EAST SHALLOWSTONE RD.

SOUTH WINGFIELD ROAD 25542

11-H-93

NOTE: DRAINAGE & UTILITY EASEMENT 5' EACH SIDE OF ALL SIDE & REAR LOT LINES.



THIS IS TO CERTIFY THAT THE PROPERTY SHOWN ON THIS PLAT WAS SURVEYED UNDER MY DIRECT SUPERVISION. PROPERTY LINES AND IMPROVEMENTS SHOWN ARE LOCATED CORRECTLY AND THAT NO VISIBLE ENCROACHMENTS EXIST UNLESS OTHERWISE SHOWN. THIS PROPERTY IS NOT LOCATED IN A DESIGNATED FLOOD HAZARD AREA.

STATE OF SOUTH CAROLINA GREENVILLE COUNTY

FREELAND & ASSOCIATES
Engineers • Land Surveyors
318 WEST STONE AVENUE
GREENVILLE, S.C.
(803) 271-4924

SUGAR CREEK
MAP 2, SEC. 3, LOT 757

PROPERTY OF
DESMOND J. MINTERN
CATHERINE M. MINTERN

PLAT BOOK	9W@ 63
DEED BOOK	
TAX MAP	
PARTY CHIEF	J.E.C.
DRAWN	K.E.G.
DATE	FEB 26, 1985
DWG. NO.	12527

FILED
GREENVILLE CO. S.C.
FEB 1 10 16 AM '85
DORIS S. TANKERSLEY
R.M.C.

RLS: JAMES R. FREELAND
NO: 4781