


MICROFILMED

MAR 21 1985

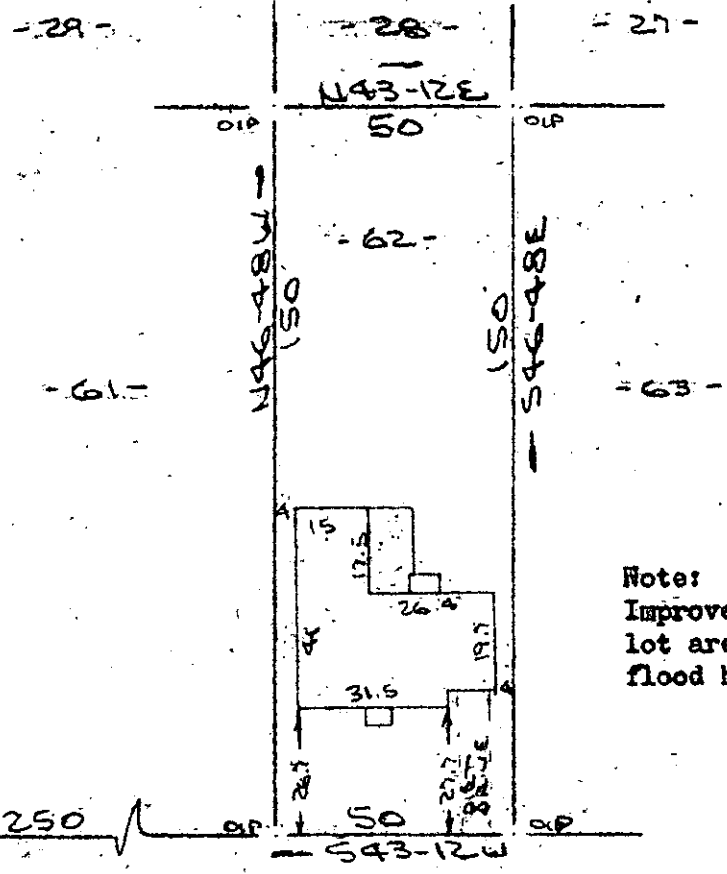


Note:
Improvements on this lot are not in a flood hazard area.

FILED
GREENVILLE CO. S.C.
MAR 21 9 27 AM '85
DONNIE S. FARRKERSLEY
R.M.C.

DIXIE AVENUE
WATER & SEWER IN ST R/W

PROPERTY OF
ROGER H. GOWER
GREENVILLE S.C.
SCALE: 1"=40' 12 MAR 1985

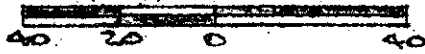

This is to certify that on the 12th day of March, 1985, I surveyed the property shown on this plat, being known as lot 62 on plat of DIXIE HEIGHTS and recorded in the RMC Office Greenville County, S. C., in Plat Book "H" at Page 46; and that the property lines, walls and buildings are as shown hereon, and that the walls and buildings located on said lot do not encroach or project on adjacent street or property, and that no adjacent walls or buildings encroach or project on said premises, and no power lines cross this property except as shown hereon.

11-J-77
277787

MAR 21 1985

R. B. Bruce
R. B. Bruce, RLS # 1952
SOUTH CAROLINA SURVEYOR
R. B. BRUCE

CAROLINA SURVEYING CO.
112 Hanly St.
Greenville, S. C.

Recordable Plat

GO TO 1 MAR 21 85 013 3.0000