


MICROFILMED

Note: Improvements on this lot are not in a flood hazard area.

Note: 5' drainage & utility easements each side all side & rear lot lines.

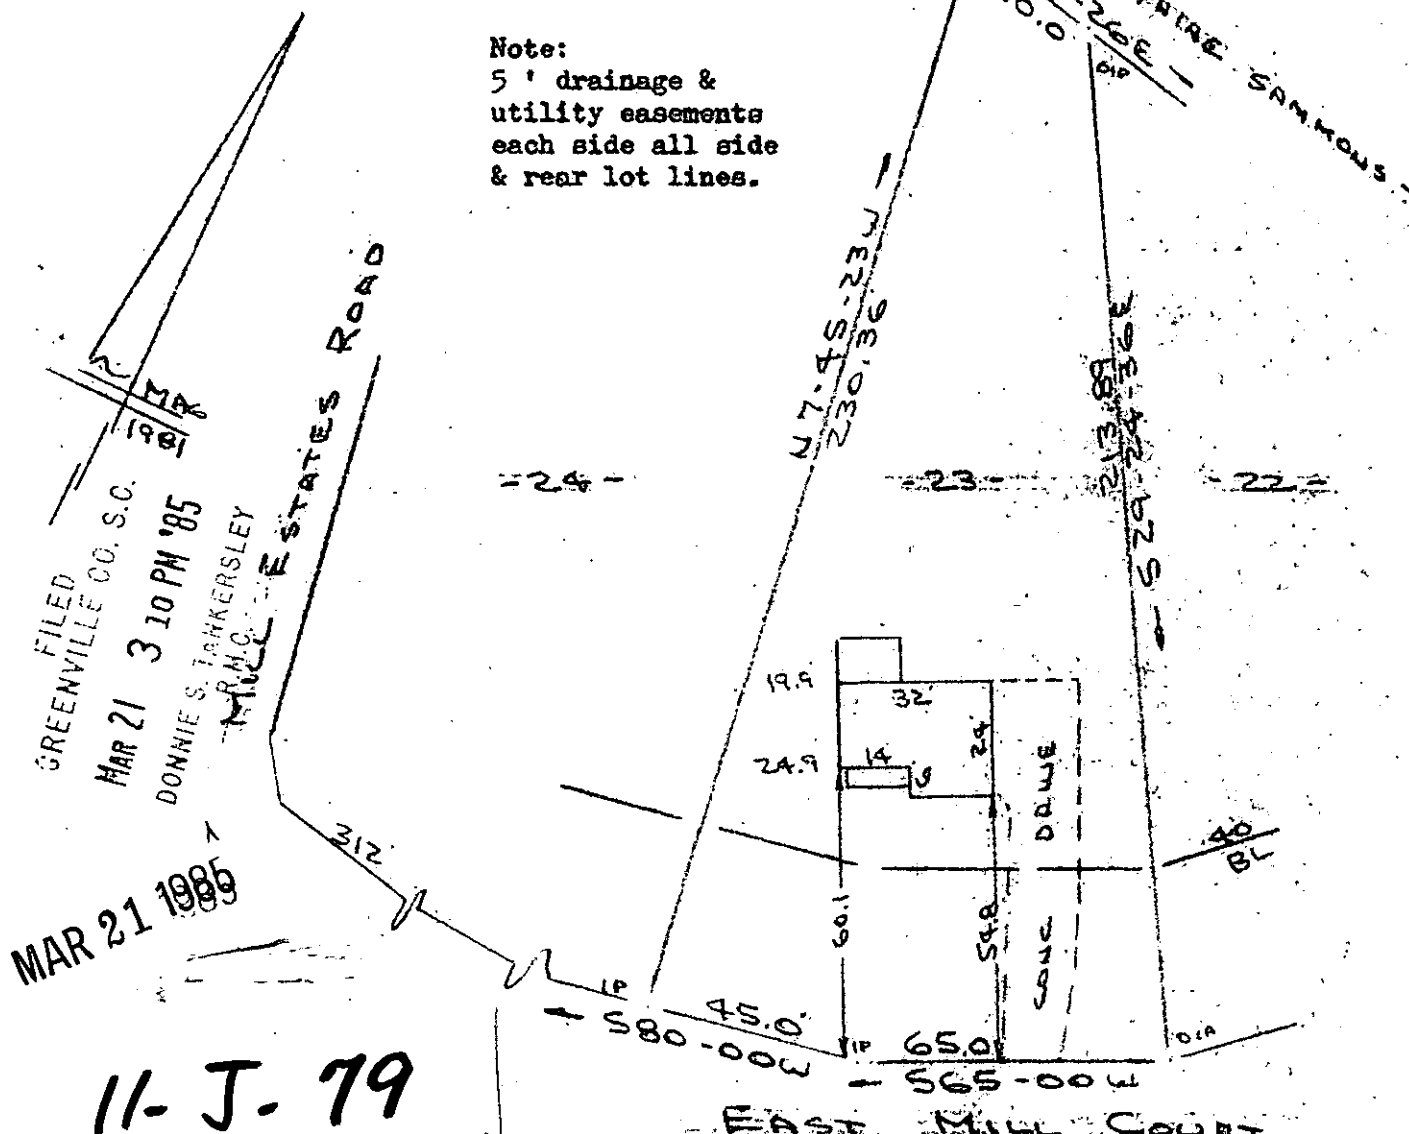

11-J-79

27792 PROPERTY OF
 HECTOR J. GONZALEZ & ANGELIQUE T. GONZALEZ
 NEAR GREENVILLE, S.C.
 SCALE 1" = 40' 18 MAR 1985



This is to certify that on the 18th day of March, 1985, I surveyed the property shown on this plat, being known as lot 23 on plat of OLD MILL ESTATES and recorded in the RMC Office Greenville County, S. C., in Plat Book "8 - P" at Page 3; and that the property lines, walls and buildings are as shown hereon, and that the walls and buildings located on said lot do not encroach or project on adjacent street or property, and that no adjacent walls or buildings encroach or project on said premises, and no power lines cross this property except as shown hereon.

R. B. Bruce
 R. B. Bruce, RLS # 1952

CAROLINA SURVEYING CO.
 112 Hanly St., Greenville, S. C.

Recordable Plat

3.00CI