


MICROFILMED

MAR 1985

PIGEON POINT
WATER & SEWER IN ST R/W

FILED
GREENVILLE CO. S.C.
MAR 26 3 09 PM '85
DANFORD ROAD
T.M.C.

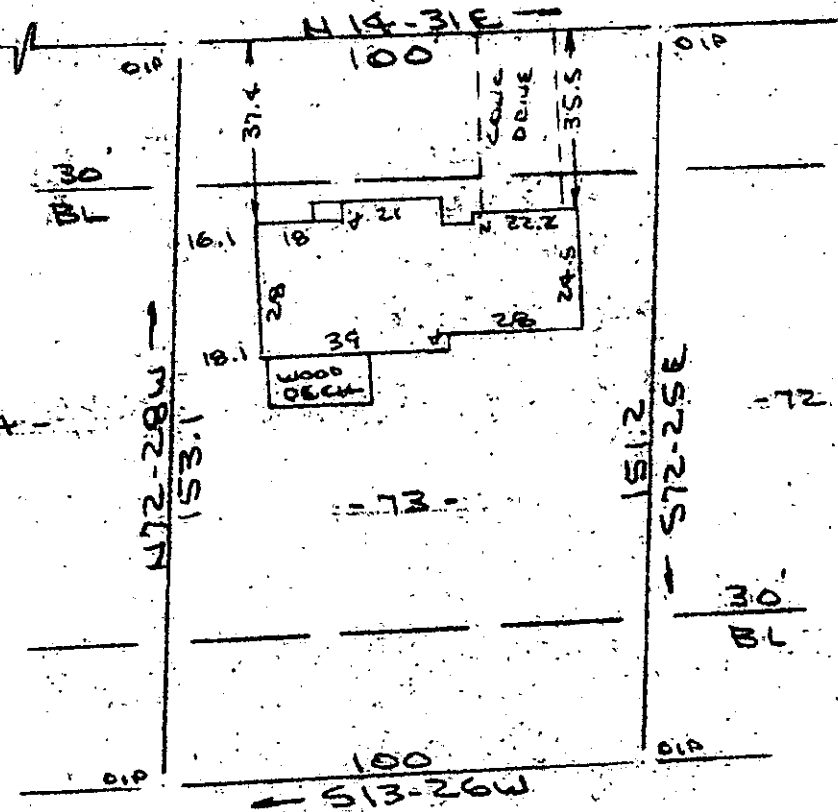


Note: Improvements on this lot are not in a flood hazard area.

Note: 5' drainage & utility easement along all side and rear lot lines.

MILLER ROAD

MAR 26 1985

PROPERTY OF
A LYNN BEUTEL & ROSINA M. BEUTEL
MAULdin, S.C.
SCALE 1" = 40' 25 MAR 1985

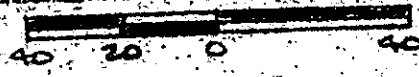

11-J-99
28377

This is to certify that on the 25th day of March, 1985, I surveyed the property shown on this plat, being known as lot 73 on plat of SECTION 7 FORRESPIER WOODS Sheet 1 of 2 and recorded in the RMC Office Greenville County, S. C., in Plat Book " 5 - P " at Pages 21 & 22; and that the property lines, walls and buildings are as shown hereon, and that the walls and buildings located on said lot do not encroach or project on adjacent street or property, and that no adjacent walls or buildings encroach or project on said premises, and no power lines cross this property except as shown hereon.

R. B. Bruce, RLS # 1952
Recordable Plat

CAROLINA SURVEYING CO.
112 Manly St., Greenville, S. C.

SC7D
1 MR26 85 069

3.00CD

MA 2-1-168