
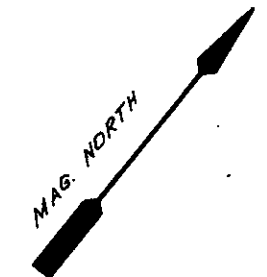


MICROFILMED

FILED  
GREENVILLE CO. S.C.  
APR 15 12 43 PM '85  
DONNIE S. TANKERSLEY  
R.M.C.

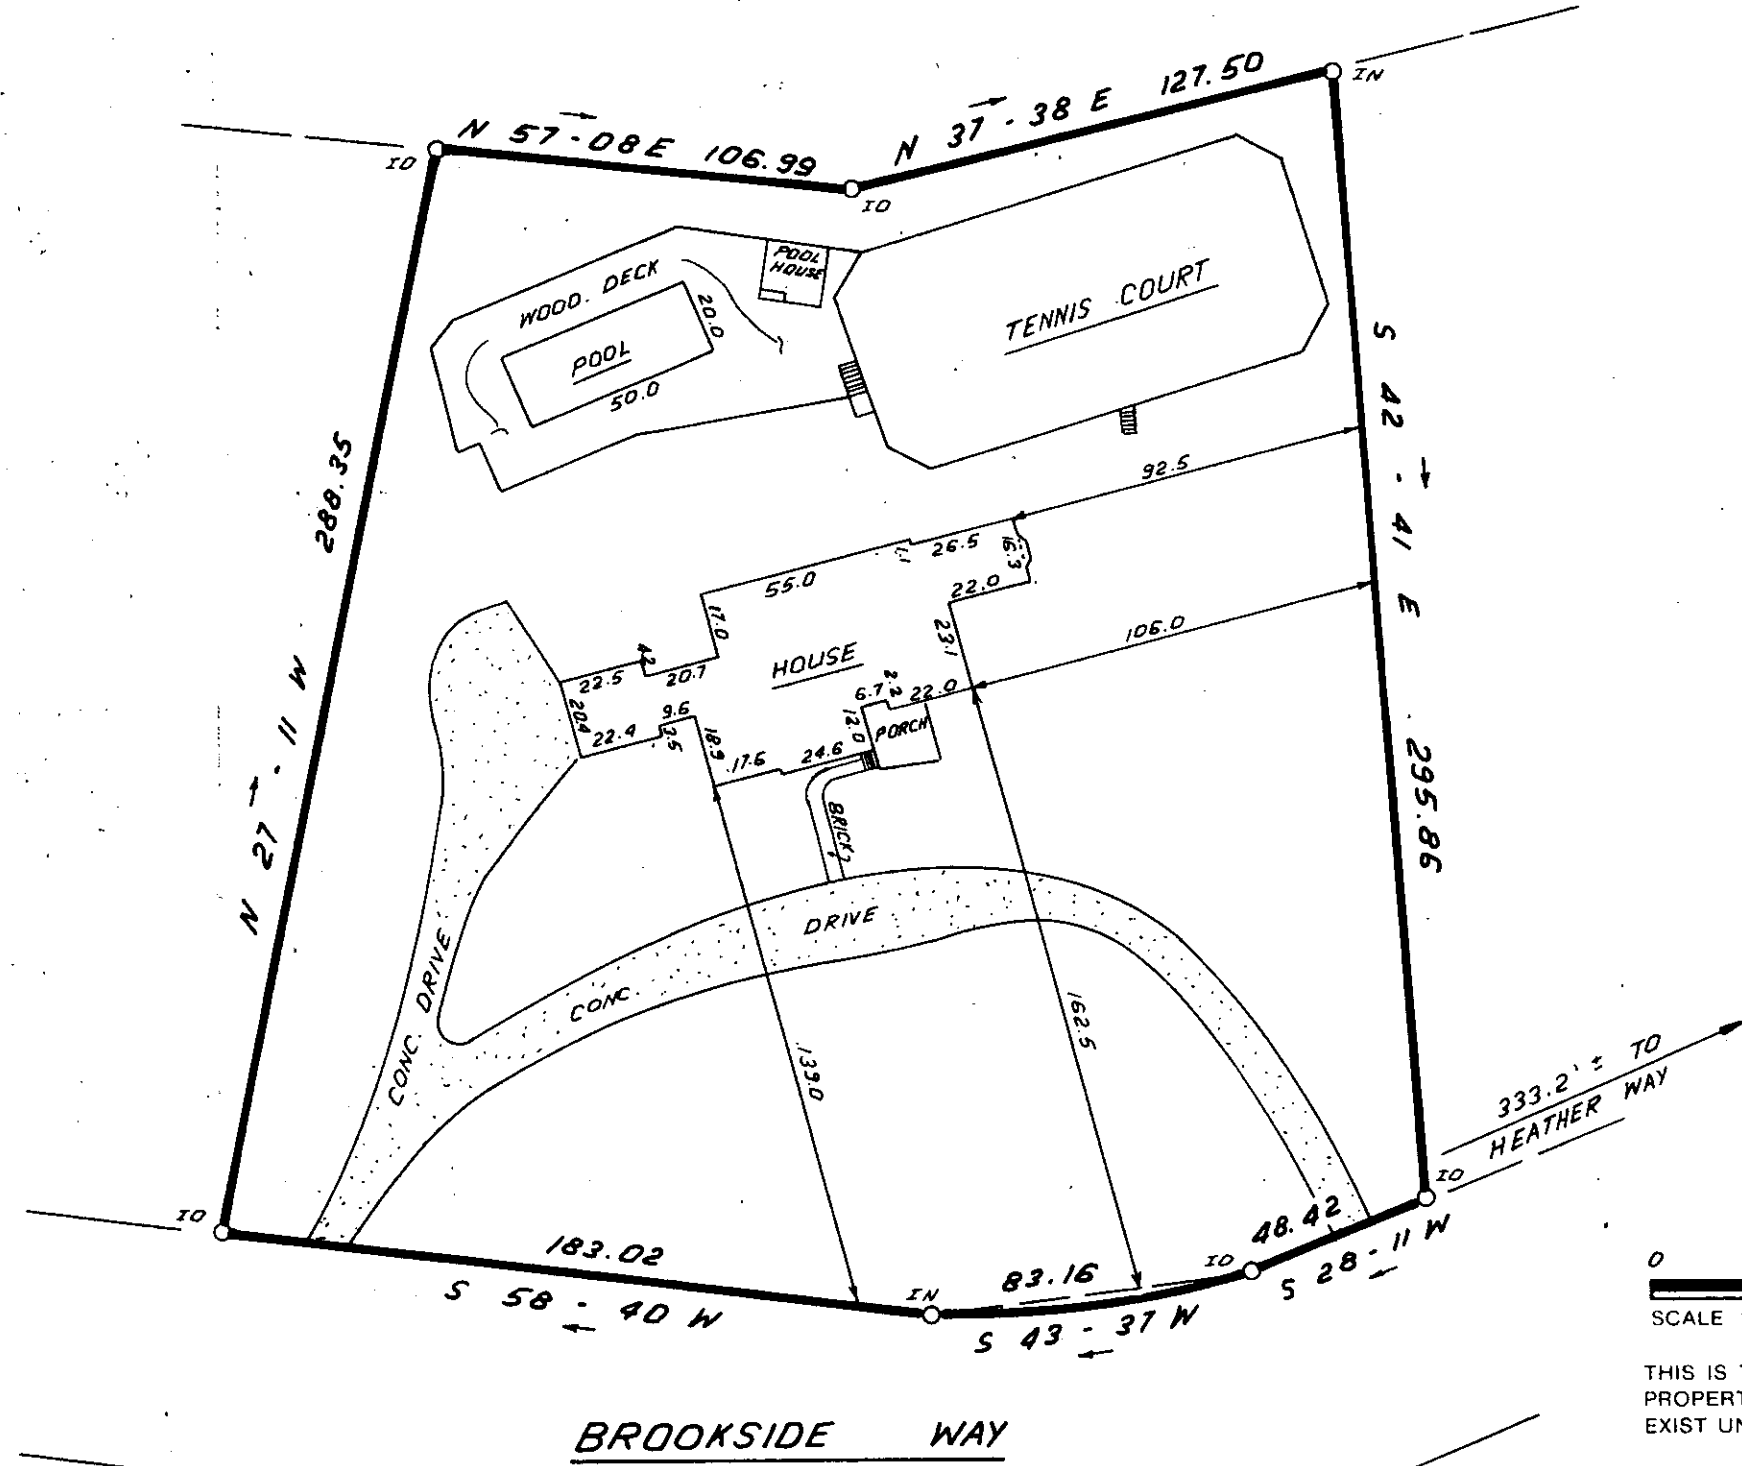

THIS IS TO CERTIFY THAT THE PROPERTY SHOWN ON THIS PLAT WAS SURVEYED UNDER MY DIRECT SUPERVISION. PROPERTY LINES AND IMPROVEMENTS SHOWN ARE LOCATED CORRECTLY AND THAT NO VISIBLE ENCROACHMENTS EXIST UNLESS OTHERWISE SHOWN. THIS PROPERTY IS NOT LOCATED IN A DESIGNATED FLOOD HAZARD AREA.

BROOKSIDE WAY

30835

11-K-56

*[Signature]*  
 SOUTH CAROLINA  
 REGISTERED SURVEYOR  
 4781  
 JAMES R. FREELAND

**STATE OF SOUTH CAROLINA  
 GREENVILLE COUNTY**

MARSHAL FOREST  
PROPERTY OF  
J. THOMAS LATHAM, JR.

**FREELAND & ASSOCIATES**  
 Engineers • Land Surveyors  
 318 WEST STONE AVENUE.  
 GREENVILLE, S.C.  
 (803) 271-4924

PLAT BOOK	H-133-134
DEED BOOK	1034-63
TAX MAP	210-5-44
PARTY CHIEF	R.A.J.
DRAWN	I.R.
DATE	3-29-85
DWG. NO.	12-728

THE PRINT MACHINE, INC. N41289