


MICROFILMED

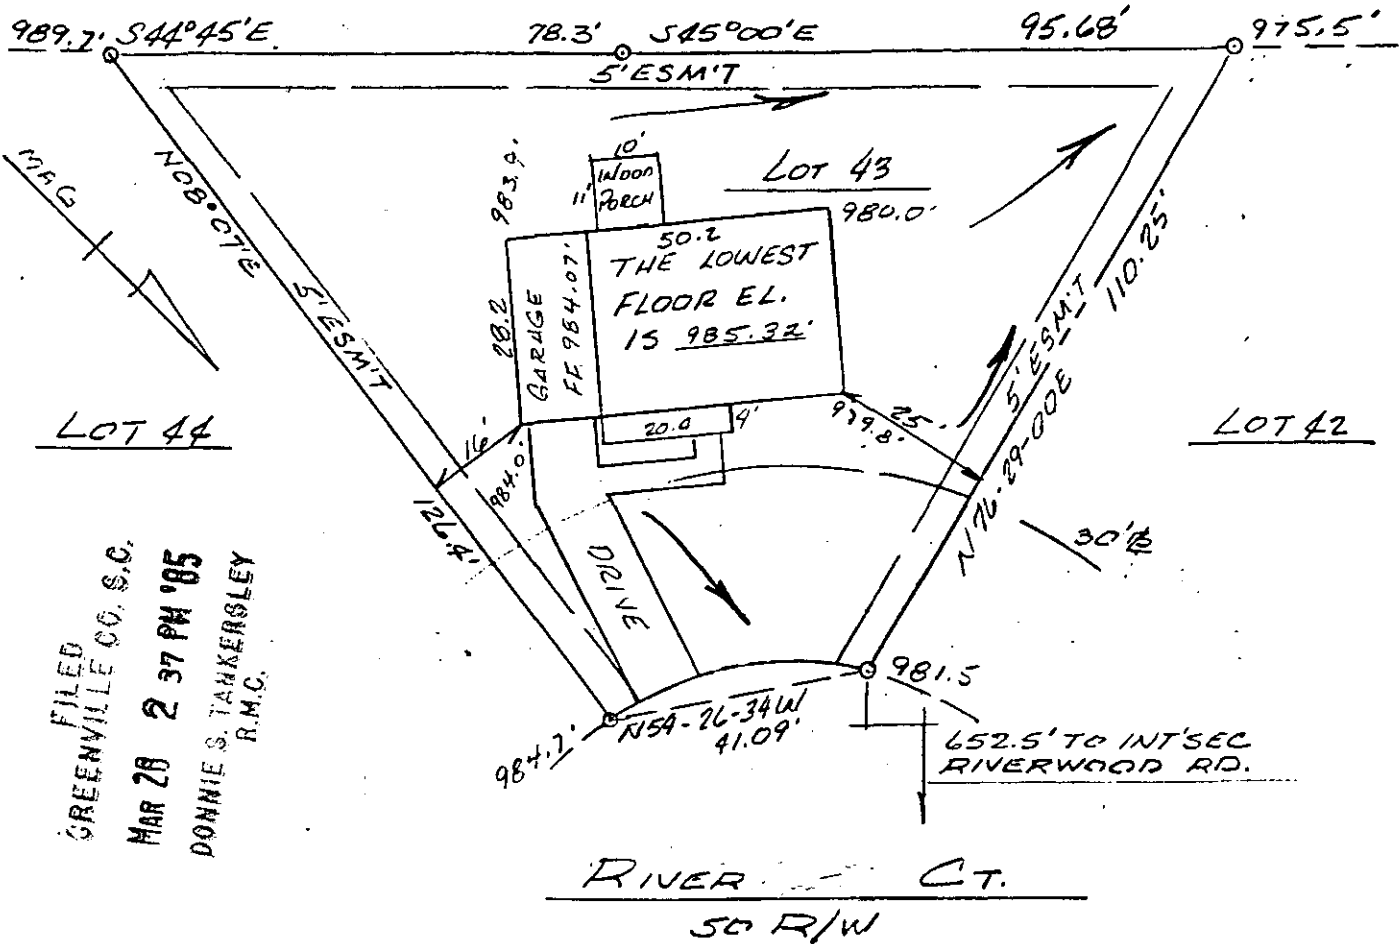

FILED
 GREENVILLE CO. S.C.
 MAR 28 2 37 PM '85
 DONNIE S. TANKERSLEY
 R.M.C.

Greenville County
 South Carolina

Date: February 6, 1984
 Scale: 1" = 30'

Plat and building location of Lot 43, Riverwoods, Section III, recorded in plat book _____, page _____, Office of R.M.C., belonging to Westminster Company, Inc.

I hereby certify that the measurements as shown on this plat are correct and there are no encroachments other than shown and that to the best of my knowledge, said lot does not lie in a designated flood zone.

This plat being recorded to correct street name. It is incorrectly named on plat recorded in 10-H page 44.

mg Baker
 Registered Land Surveyor, S.C. #6571

MAR 28 1985

11-2-16

28682

3.000
 Cheaner engineering co., inc.
 greenwood, s.c.

