

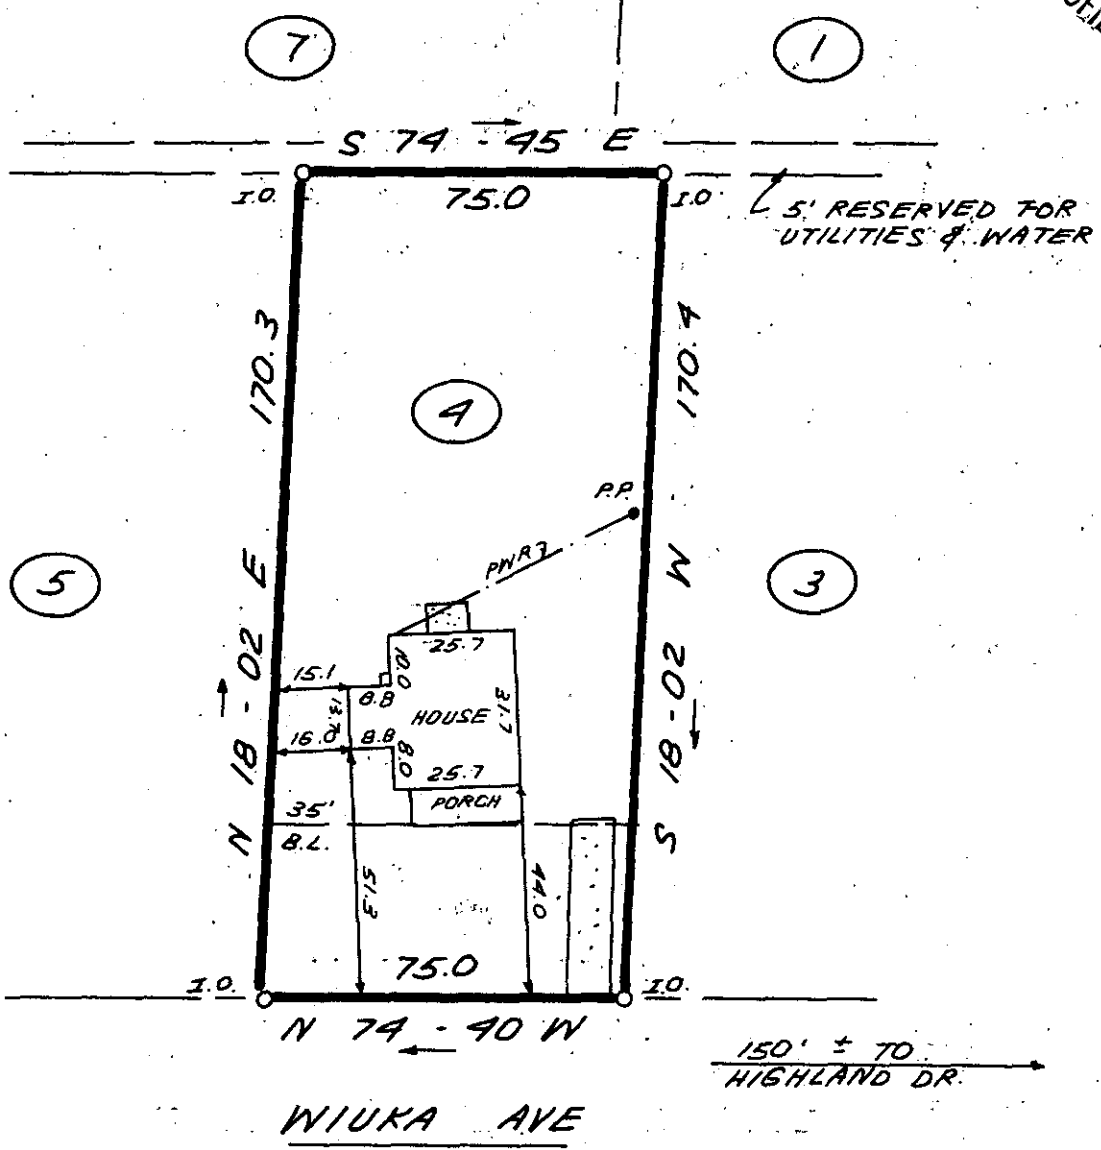


MICROFILMED

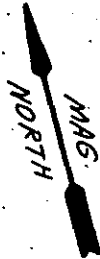

FILED
GREENVILLE CO., S.C.
APR 1 12 39 PM '85
DONNIE S. JANKERSLEY
R.M.C.

APR 1 1985

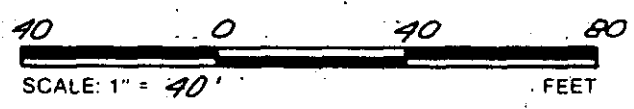


11-6-37 29055

THIS IS TO CERTIFY THAT THE PROPERTY SHOWN ON THIS PLAT WAS SURVEYED UNDER MY DIRECT SUPERVISION. PROPERTY LINES AND IMPROVEMENTS SHOWN ARE LOCATED CORRECTLY AND THAT NO VISIBLE ENCROACHMENTS EXIST UNLESS OTHERWISE SHOWN. THIS PROPERTY IS NOT LOCATED IN A DESIGNATED FLOOD HAZARD AREA.

**STATE OF SOUTH CAROLINA
GREENVILLE COUNTY**

FREELAND & ASSOCIATES
Engineers • Land Surveyors
318 WEST STONE AVENUE.
GREENVILLE, S.C.
(803) 271-4924

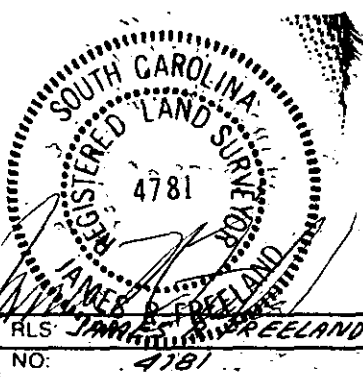

EAST HIGHLANDS EST.
SEC. 6, LOT 4
PROPERTY OF
CHARLES E. CAUBLE 185 1450

| | |
|-------------|----------|
| PLAT BOOK | 00 109 |
| DEED BOOK | 1216-786 |
| TAX MAP | 269-14-5 |
| PARTY CHIEF | J.E.C. |
| DRAWN | K.E.S. |
| DATE | 3-28-85 |
| DWG. NO. | 12721 |