


Note: Improvements on this lot are not in a flood hazard area.

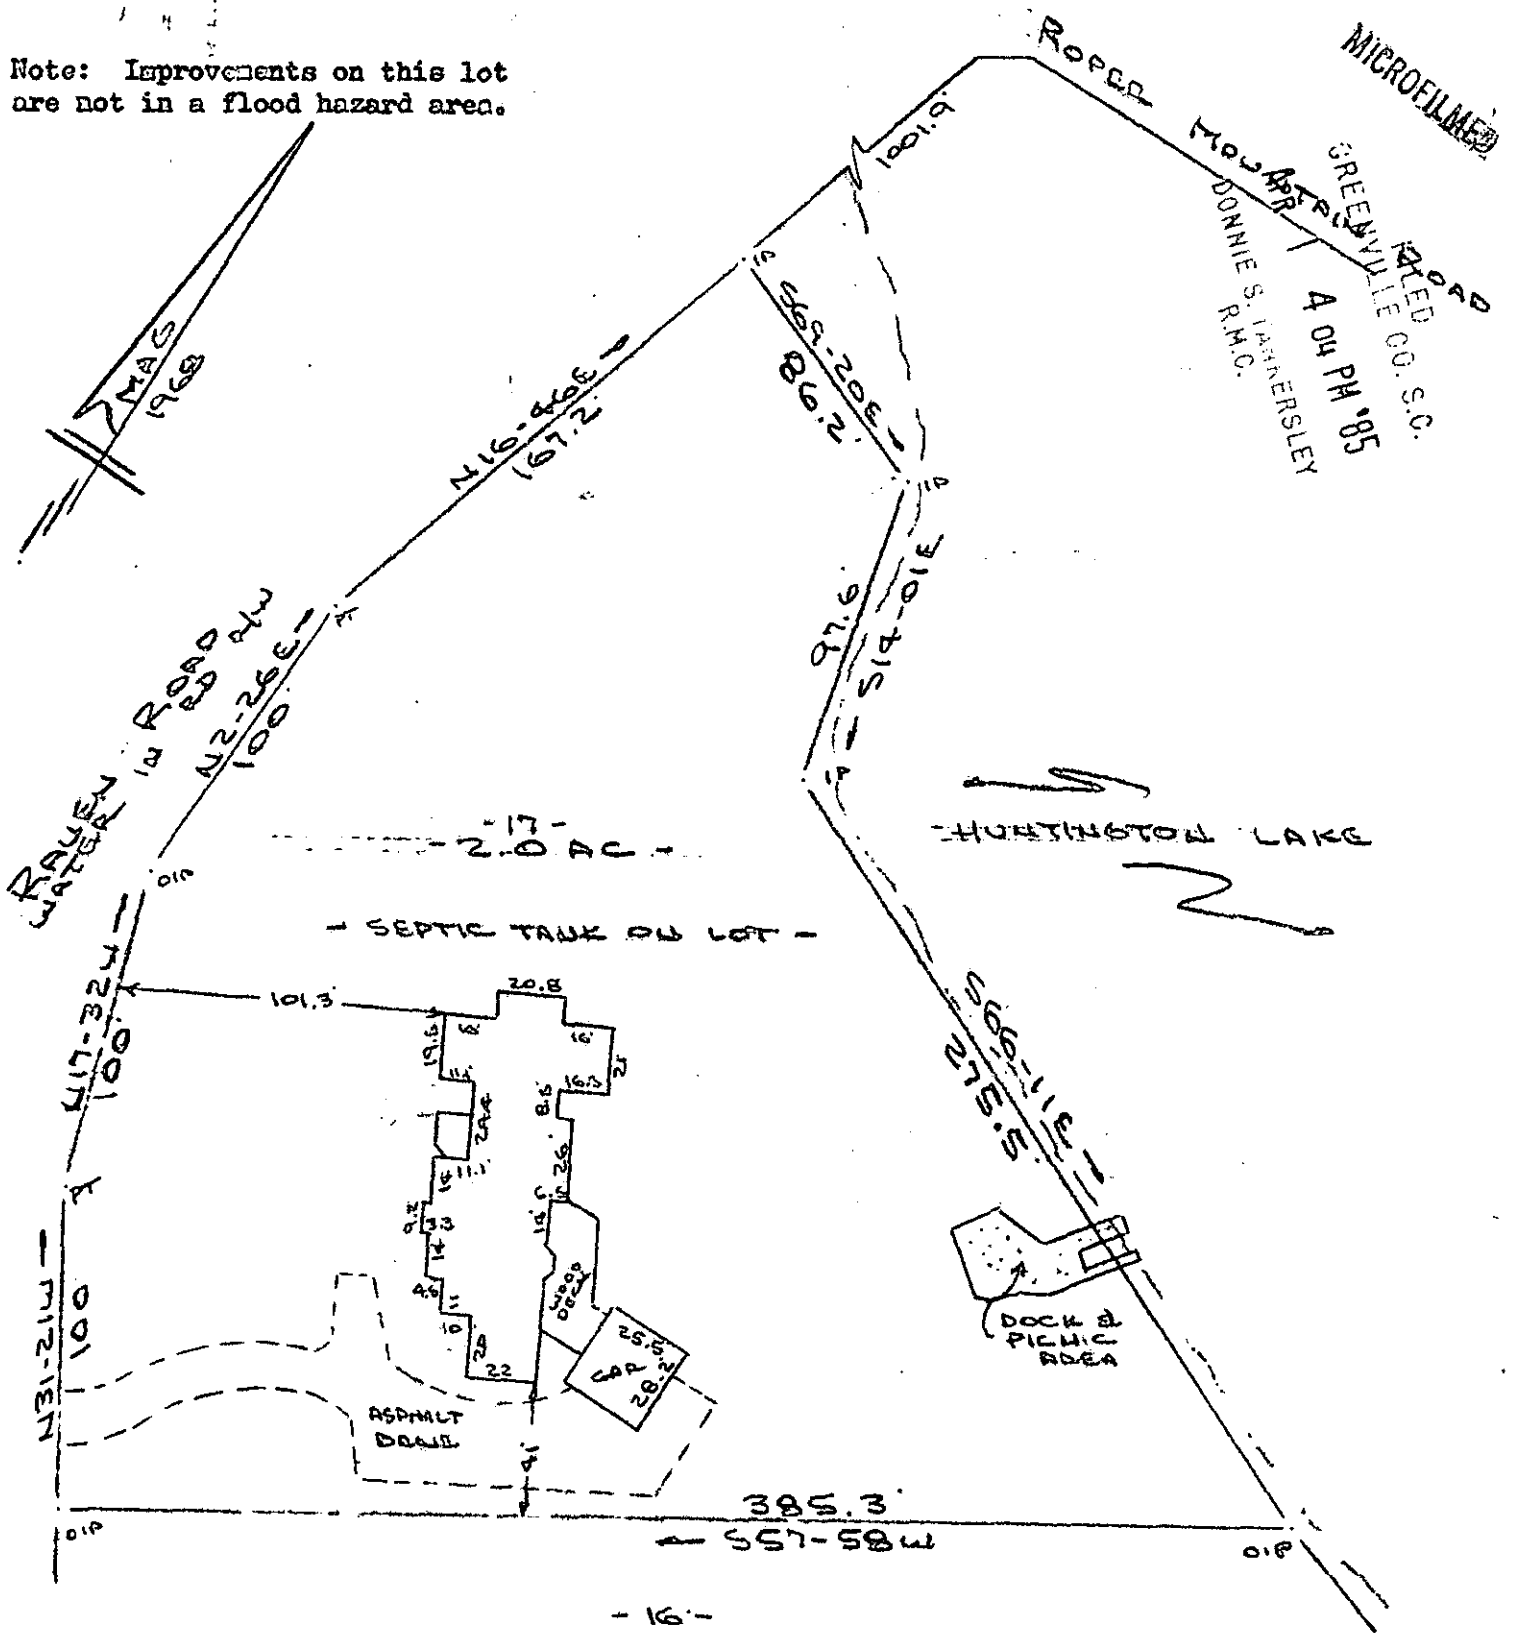

JACK F. PROPERTY OF
 JACK F. MAYER & BETTY B. MAYER
 NEAR GREENVILLE, GREENVILLE CO., S.C.
 SCALE: 1"=60' 26 MAR 1985



This is to certify that on the 26th day of March, 1985, I surveyed the property shown on this plat, being known as lot 17 (2.0 acres) on plat of Sheet No. 4 HUNTINGTON and recorded in the REC Office Greenville County, S. C., in Plat Book " WNW " at Page 26 and also known as PROPERTY OF JACK F. MAYER & BETTY B. MAYER and recorded in Plat Book at Page ; and that the property lines, walls and buildings are as shown hereon, and that the walls and buildings located on said lot do not encroach or project on adjacent street or property, and that no adjacent walls or buildings encroach or project on said premises, and no power lines cross this property except as shown hereon.

11-L-46 29188

R. B. Bruce

R. B. Bruce, RES # 1952

CAROLINA SURVEYING CO.
 112 Manly St.
 Greenville, S. C.

Recordable Plat