


MICROFILMED

WILKINSON STREET
WATER & SEWER IN WEST R/W

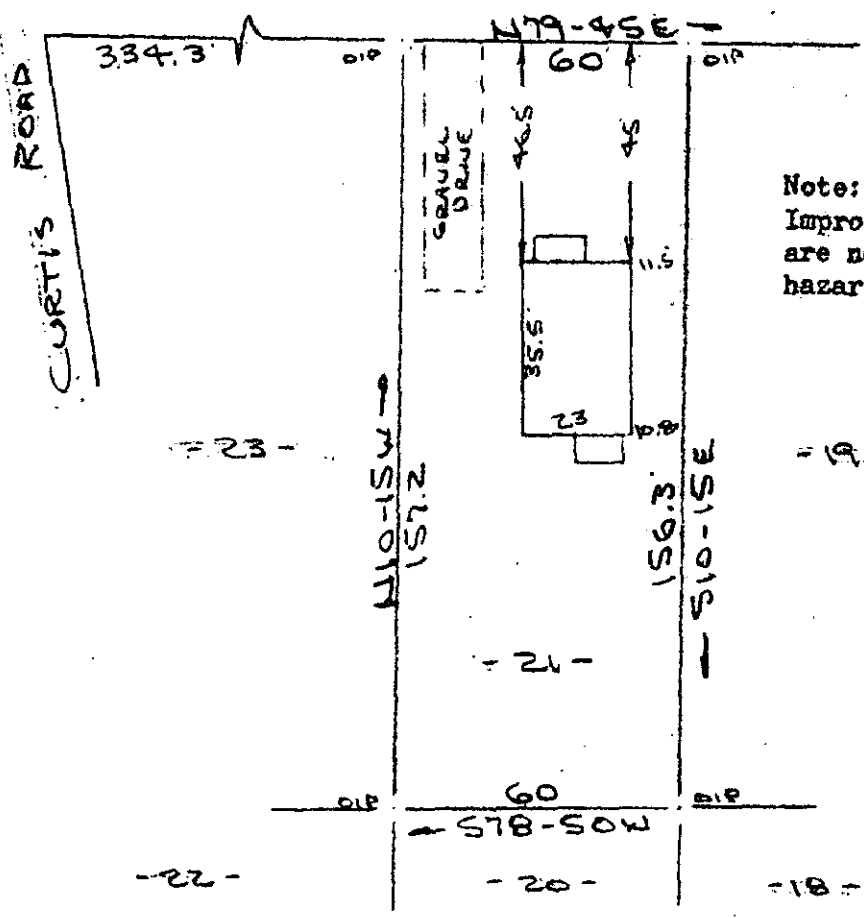

FILED
GREENVILLE CO. S.C.
APR 4 10 50 AM '85
DONNIE S. LANKERSLEY
R.M.C.

PROPERTY OF
C. CHARLES MEYER & RACHEL C. MEYER
NEAR GREENVILLE, S.C.
SCALE: 1"=40' 1 APR 1985



This is to certify that on the 1st day of April, 1985, I surveyed the property shown on this plat, being known as lot 21 on plat of WEST BOULEVARD and recorded in the RMC Office Greenville County, S. C., in Plat Book " F " at Page 246; and that the property lines, walls and buildings are as shown hereon, and that the walls and buildings located on said lot do not encroach or project on adjacent street or property, and that no adjacent walls or buildings encroach or project on said premises, and no power lines cross this property except as shown hereon.

11 - N - 75 ✓ 23794

APR 4 1985

R. B. Bruce

R. B. Bruce, RLS # 1952

CAROLINA SURVEYING
112 Manly St.
Greenville, S. C.

Recordable Plat
APR 10 1985
R.M.C.

GC10 -1 AP04 85 007

3.0000