

DAVIS DRIVE

DAVIS DRIVE

FILED
 GREENVILLE CO. S.C.
 APR 11 4 27 PM '85
 DONNIE S. JANKERSLEY
 R.M.C.

APR 11 1985

PROPERTY OF

HOLLAND REEVES

NEAR GREENVILLE

GREENVILLE COUNTY S. C.

WEBB SURVEYING & MAPPING CO.


I hereby certify that on APRIL 4 1985
 I rechecked the parcel shown hereon
 being the greater portion of the parcel
 as shown according to a plat dated Dec.
 15, 1983 and recorded in plat book 10F
 on page 27 in the R.M.C. office of
 Greenville County, and that the property
 lines, buildings, and walls are as shown
 hereon, that no buildings or walls encroach
 onto adjacent streets or property, and
 no walls or buildings encroach or project
 onto these premises, and that the
 structures are not within a flood hazard
 area.

REGISTERED
 1577
 CHARLES F. WEBB
 SURVEYOR

Charles F. Webb PLS 30560

SCALE 1"=50'

APRIL 4, 1985

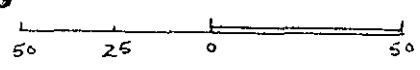

11-L-92