
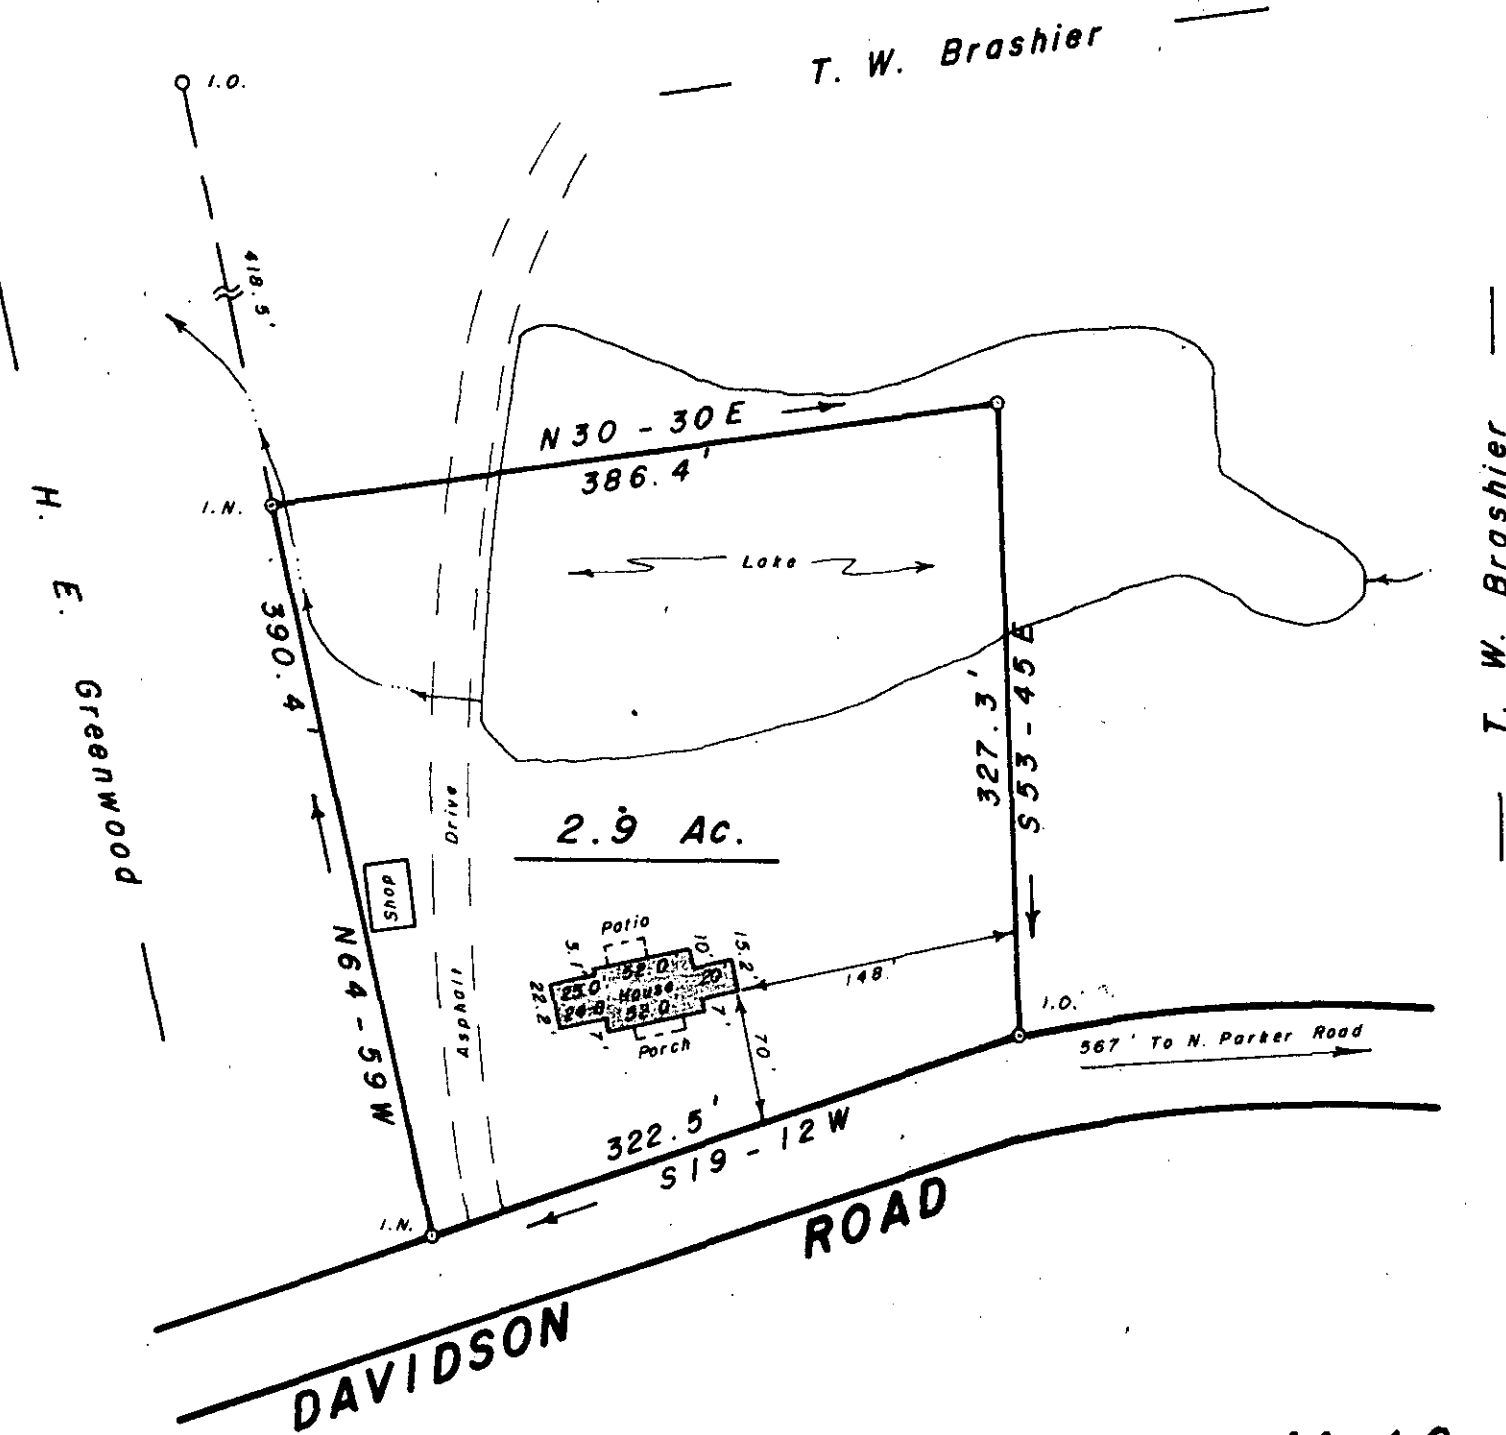


Legend: I.O. - - - Old Iron Pin
 I.N. - - - New Iron Pined
 GREENVILLE CO. S.C.
 MAY 31 4 15 PM '85
 DONNIE S. YANKERSLEY
 R.M.C.

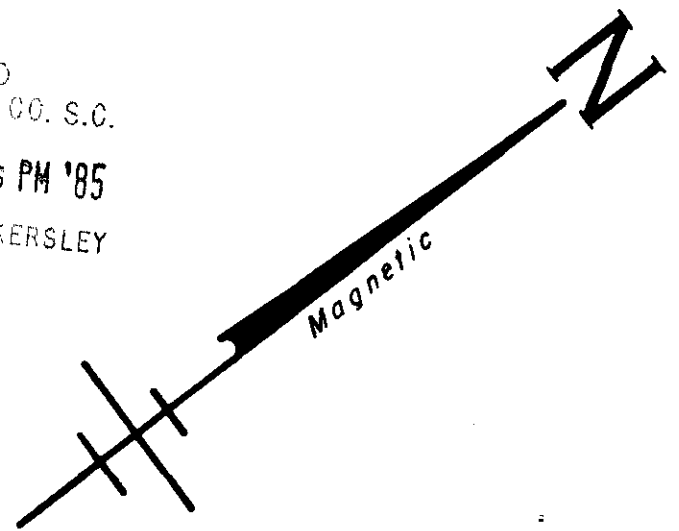

11-N-58 ✓

36534

SURVEY FOR

MAY 31 1985

IRMA SCARANO


NEAR PARIS MTN. GREENVILLE CO.

SOUTH CAROLINA

MAY 27, 1985

THIS IS TO CERTIFY THAT THE PROPERTY SHOWN ON THIS PLAT WAS SURVEYED UNDER MY DIRECT SUPERVISION. PROPERTY LINES AND IMPROVEMENTS SHOWN ARE LOCATED CORRECTLY AND THAT NO VISIBLE ENCROACHMENTS EXIST UNLESS OTHERWISE SHOWN. THIS PROPERTY IS NOT LOCATED IN A DESIGNATED FLOOD HAZARD AREA.

SCALE: 1" = 100'

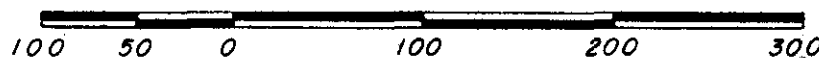

W. R. WILLIAMS, JR.
 ENGINEER/SURVEYOR
 P. E. & L. S. No. 3979
 15 S. MAIN STREET
 TRAVELERS REST, S. C.
 29690

"I hereby certify that the ratio of precision of the field survey is 1/5000 as shown hereon and the area was determined by DMD method of area calculation."

W. R. Williams
 P. E. & L. S. No. 3979