Note: Improvements on this property are not in a flood hazard area.

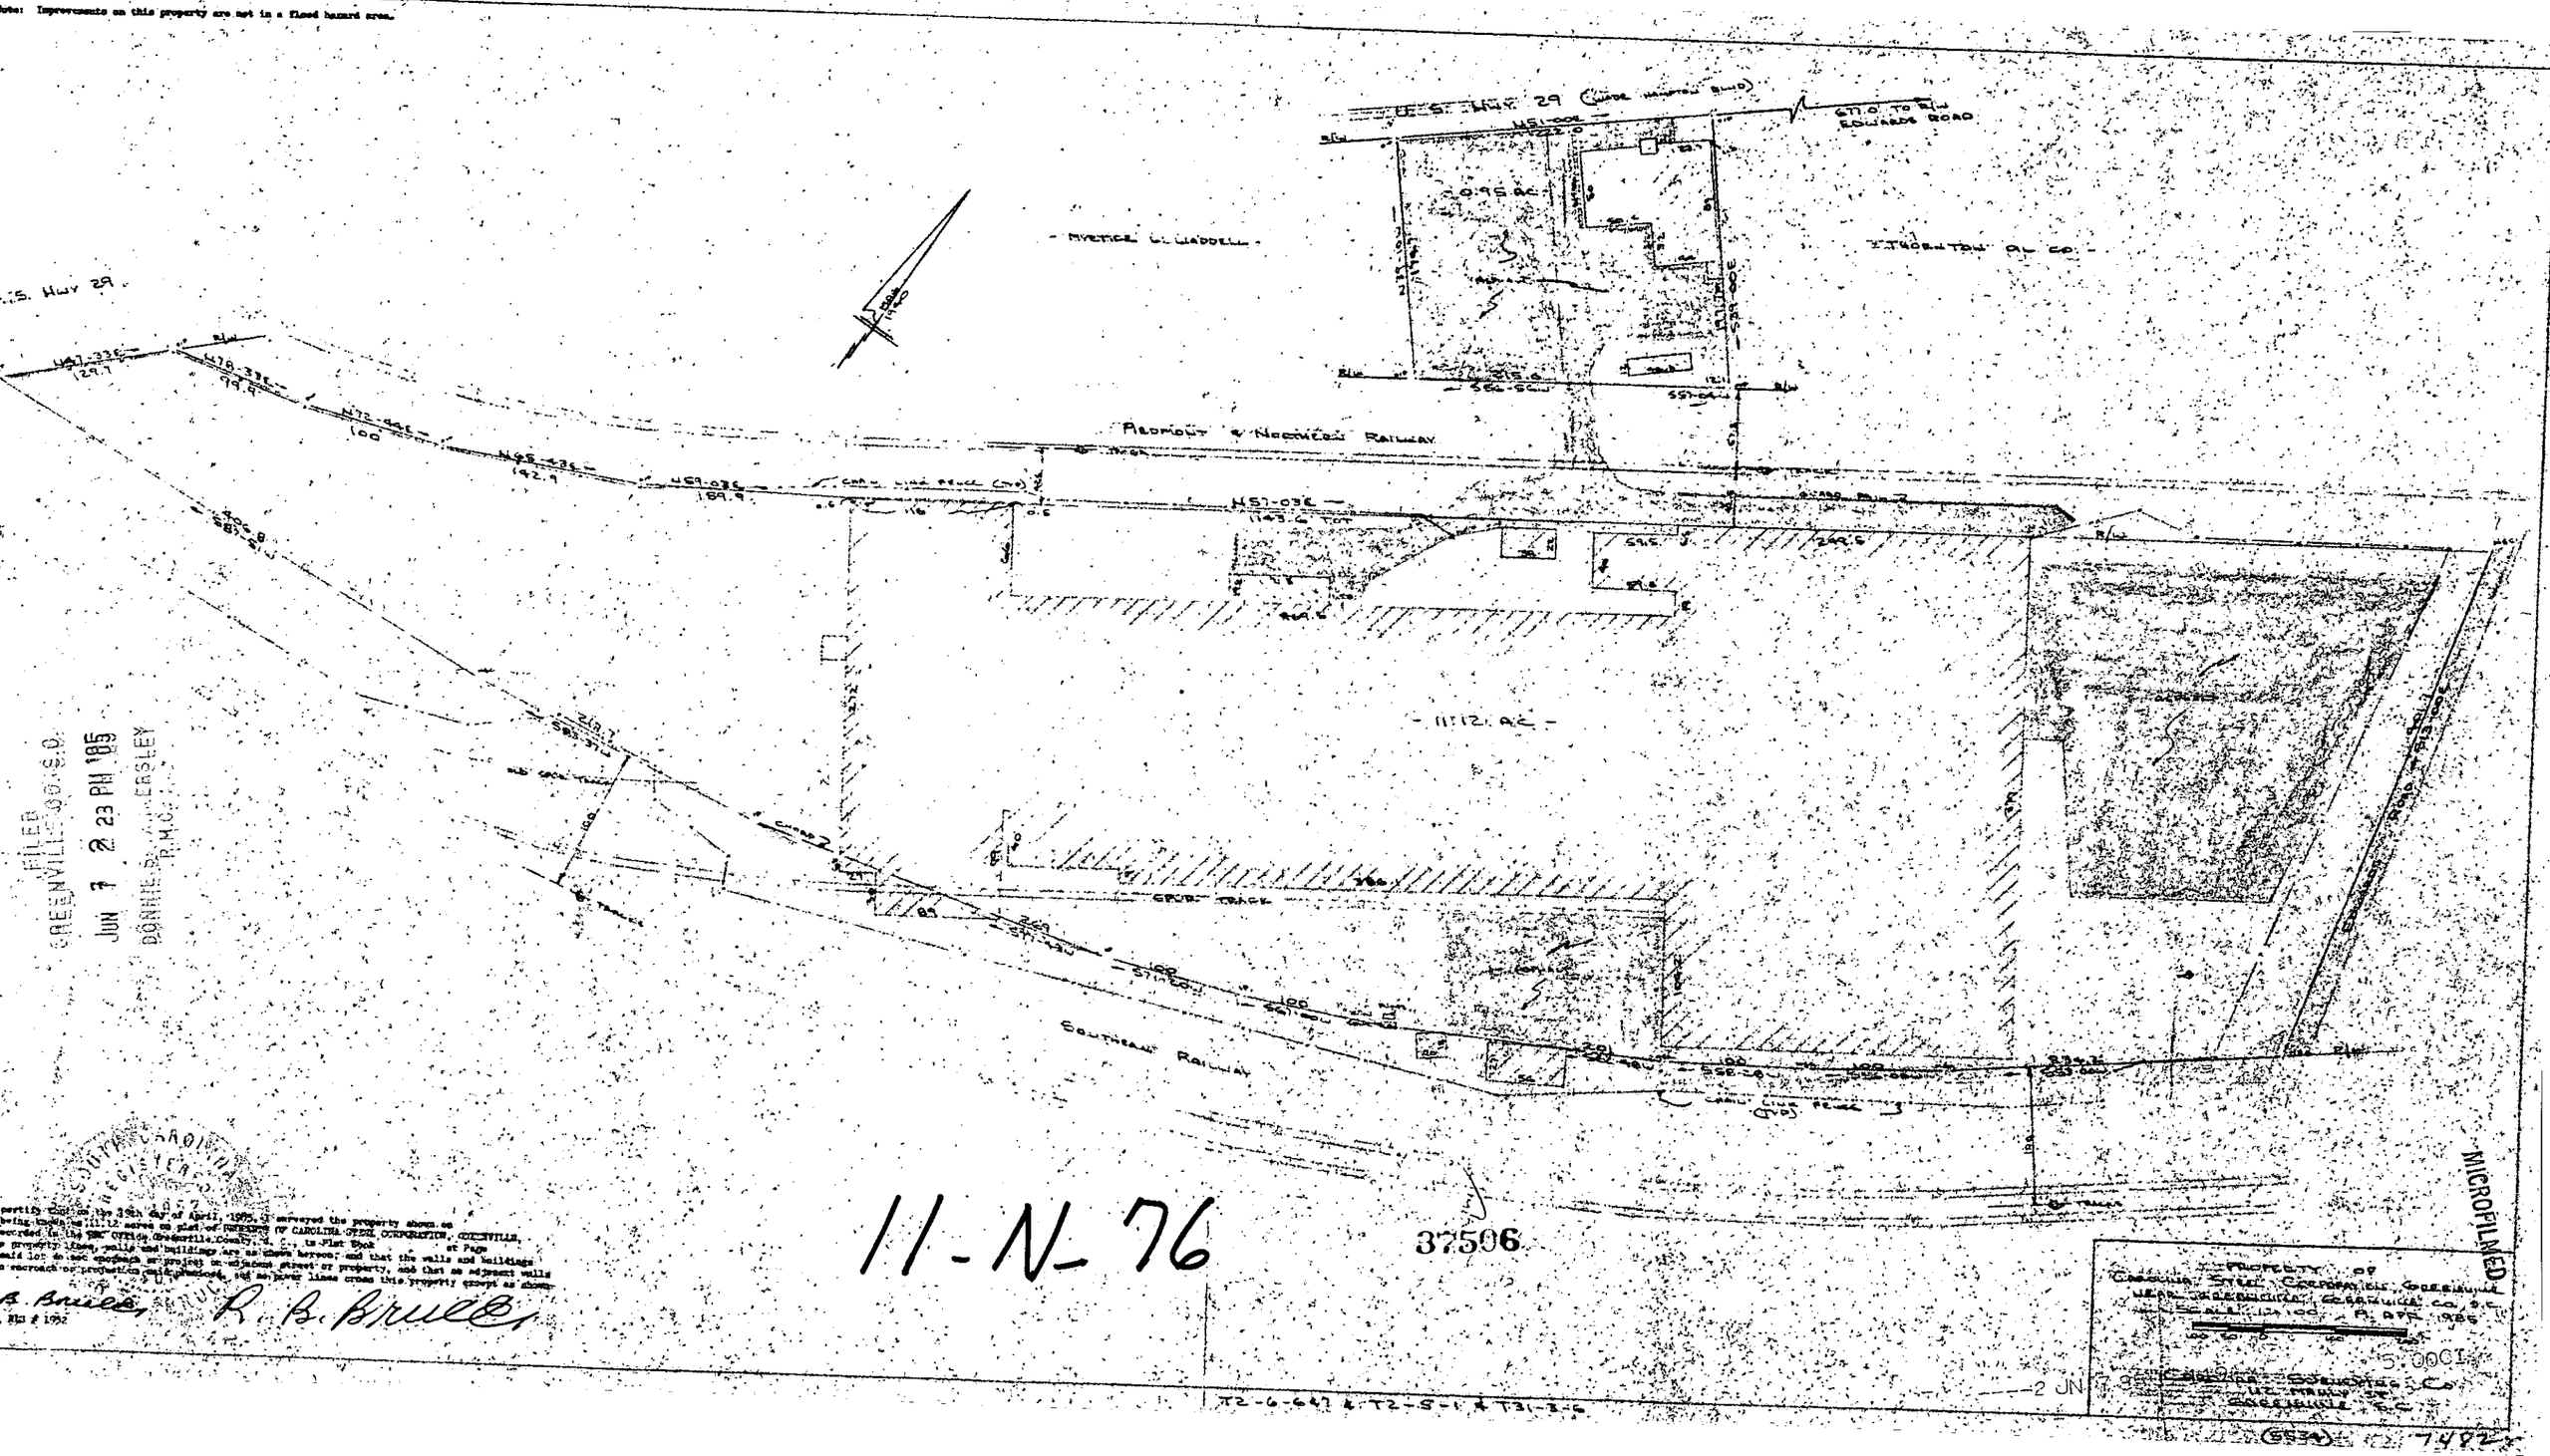

FILED
GREENVILLE CO. S.C.
JUN 7 2 23 PM '85
DONNIE S. ... ERSLEY
R.M.C.

11-N-76

37506

PROPERTY OF
CAROLINA STEEL CORPORATION, GREENVILLE
NEAR GREENVILLE, GREENVILLE CO. S.C.
SCALE 1"=100' APR 1985

5.00CI

CAROLINA SURVEYING CO.
112 MANLY ST.
GREENVILLE, S.C.

(5534) 7482

MICROFILMED

...ertify that on the 29th day of April, 1985, I surveyed the property shown on ... being known as 11.12 acres on plat of PROPERTY OF CAROLINA STEEL CORPORATION, GREENVILLE, ... recorded in the RMC Office, Greenville County, S. C., in Plat Book at Page ... property lines, walls and buildings are as shown hereon; and that the walls and buildings ... said lot do not encroach or project on adjacent street or property, and that no adjacent walls ... encroach or project on said premises, and no power lines cross this property except as shown.

R. B. Bruce
RLS # 1952

R. B. Bruce

T2-6-647 & T2-5-1 & T31-3-6

2 JN 7 85