
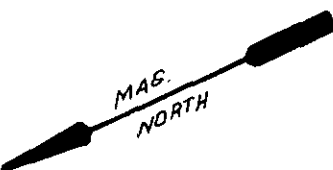


571 FT TO ROSEMARY LANE  
 IVANHOE CIRCLE

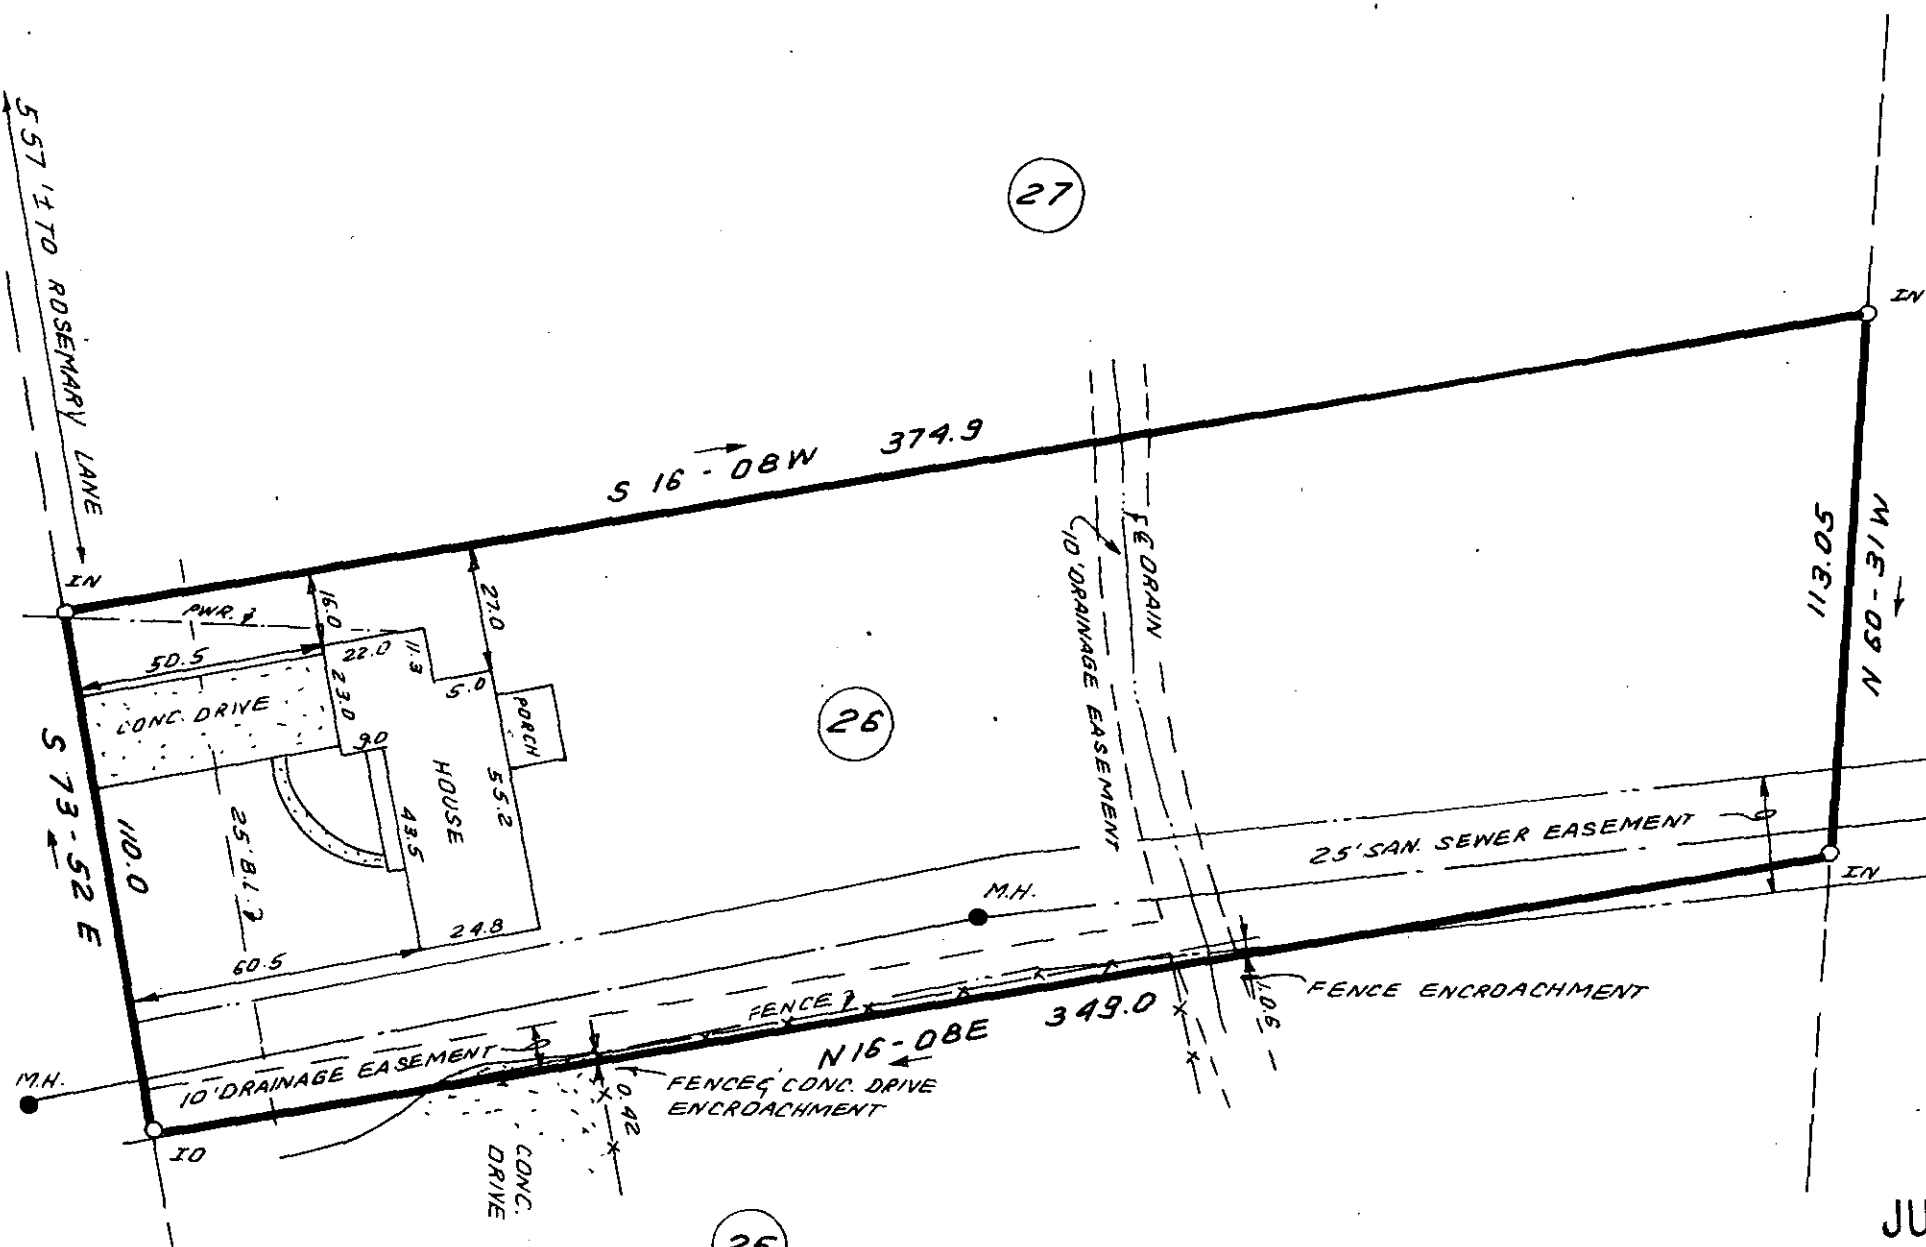

FILED  
 GREENVILLE CO. S.C.  
 JUN 20 12 36 PM '85  
 DONNIE S. NERSLEY  
 R.H.C.


38869

JUN 20 1985

11-N-93



THIS IS TO CERTIFY THAT THE PROPERTY SHOWN ON THIS PLAT WAS SURVEYED UNDER MY DIRECT SUPERVISION. PROPERTY LINES AND IMPROVEMENTS SHOWN ARE LOCATED CORRECTLY AND THAT NO VISIBLE ENCROACHMENTS EXIST UNLESS OTHERWISE SHOWN. THIS HOUSE IS NOT LOCATED IN A DESIGNATED FLOOD HAZARD AREA.

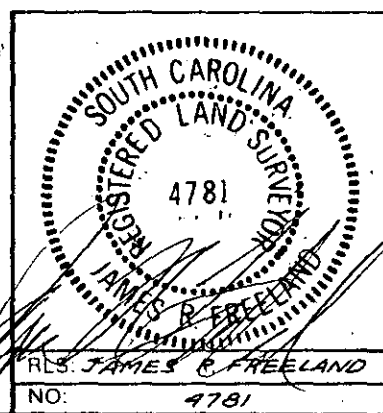

STATE OF SOUTH CAROLINA  
 GREENVILLE COUNTY

ROSEDALE  
 LOT 26  
 PROPERTY OF  
 ALLEN R. ROBERTSON  
 PATRICIA W. ROBERTSON

FREELAND & ASSOCIATES  
 Engineers • Land Surveyors  
 318 WEST STONE AVENUE.  
 GREENVILLE, S.C.  
 (803) 271-4924

PLAT BOOK	YY 35
DEED BOOK	1074-315
TAX MAP	P 16.2-1-285
PARTY CHIEF	L.T.
DRAWN	B.R.
DATE	6-6-85
DWG. NO.	13/53

THE PRINT MACHINE, INC. N41289

MICROFILMED