MICROFILMED

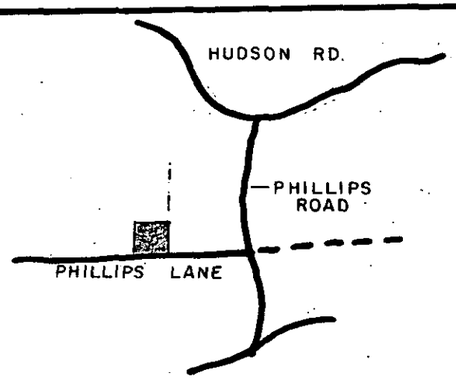

FILED
GREENVILLE CO., S.C.
JUL 18 1 19 PM '85
DONNIE S. TANKERSLEY
R.M.C.

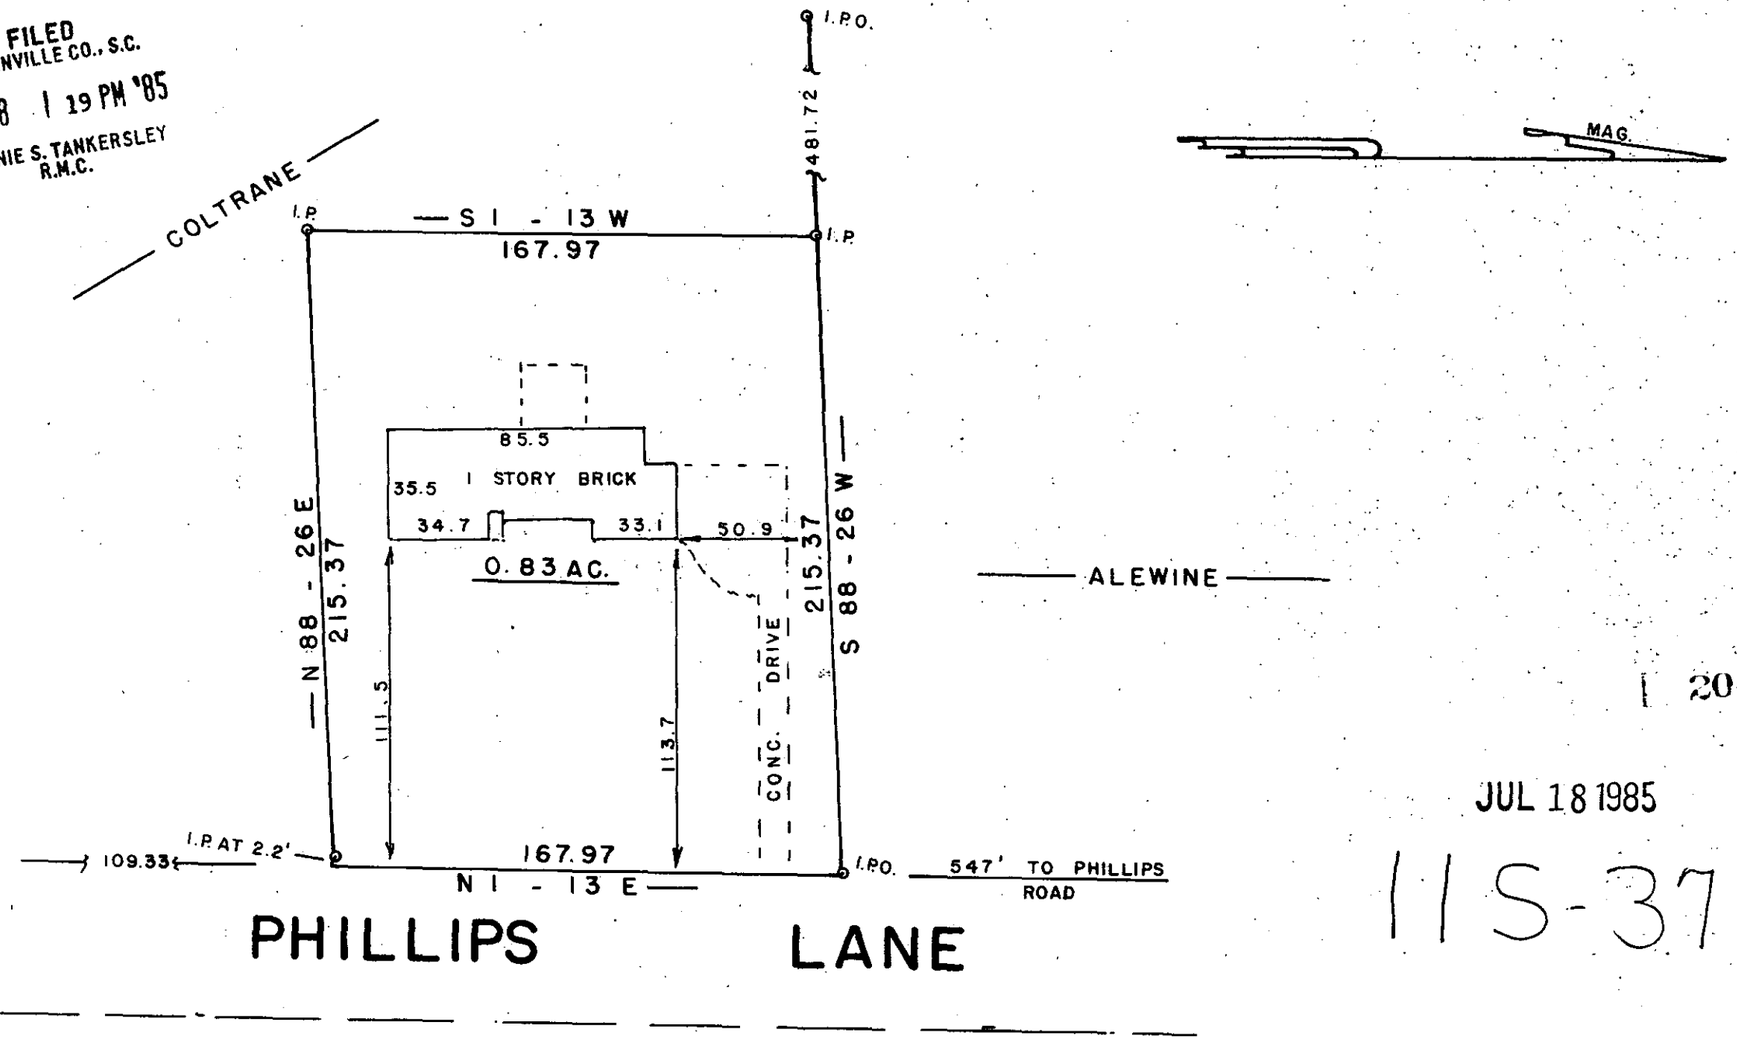

2045

JUL 18 1985

115-37

SURVEY FOR

GEORGE S. COLTRANE JR.
SYLVIA B. COLTRANE

GREENVILLE CO. SOUTH CAROLINA

WEBB SURVEYING & MAPPING GROUP
P.O. BOX 4756 - 29608

50 0 50 100
SCALE 1" = 50 FT.
DATE JULY 1985

CHARLES F. WEBB
REGISTERED
1577
LAND SURVEYOR
SOUTH CAROLINA

☑ I HEREBY CERTIFY THE RATIO OF PERECSON OF THE FIELD SURVEY IS 1/ 5000 THE AREA WAS DETERMINED BY D M D CALCULATION

☑ I HEREBY CERITIFY THAT THE PROPERTY LINES AND ANY INPROVMENTS ARE CORRECT AND NO VISIBLE ENCROACHMENTS EXIST UNLESS OTHERWISE SHOWN

☑ THIS PROPERTY IS SUBJECT TO ANY EASEMENTS OR RIGHT OF WAYS OF RECORD OR NOT OF RECORD

☑ TH IS PRO. IS NOT WITHIN A FLOOD HAZARD AREA

REF. — PLAT OF J.C. PHILLIPS
BY WEBB SURVEYING
B.B.R. 540.3-1-PT. 9.13

THE PRINT MACHINE, INC. N56/84

500 85-1309