

FILED
 GREENVILLE CO., S.C.
 OCT 4 4 44 PM '85
 DONNIE S. TANKERSLEY
 R.M.C.


LAKE FOREST DRIVE

OCT 4 1985 11921 ✓

12A-11

SURVEY FOR
CHARLES I. REID
LINDA F. REID
 GREENVILLE CO. SOUTH CAROLINA

WEBB SURVEYING & MAPPING GROUP
 P.O. BOX 4756 - 29608

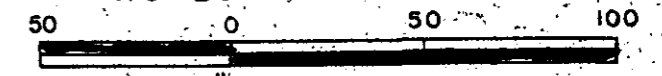


SCALE 1" = 50 FT.

DATE 2 SEPT 1985 666

5.0001

REF. PLAT BOOK W PAGE 87

- I HEREBY CERTIFY THE RATIO OF PERECSON OF THE FIELD SURVEY IS 1/ 8500 THE AREA WAS DETERMINED BY D.M.D. CALCULATION
- I HEREBY CERTIFY THAT THE PROPERTY LINES AND ANY IMPROVMENTS ARE CORRECT AND NO VISIBLE ENCROACHMENTS EXIST UNLESS OTHERWISE SHOWN
- THIS PROPERTY IS SUBJECT TO ANY EASEMENTS OR RIGHT OFWAYS OF RECORD OR NOT OF RECORD
- THIS SITE IS NOT WITHIN A FLOOD HAZARD AREA

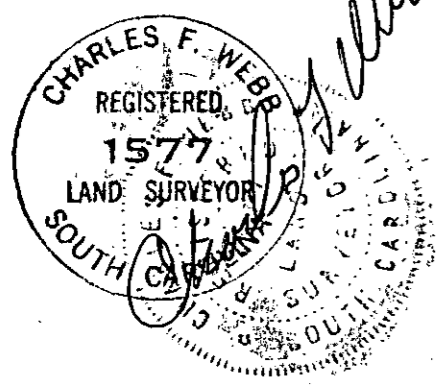

5-118