
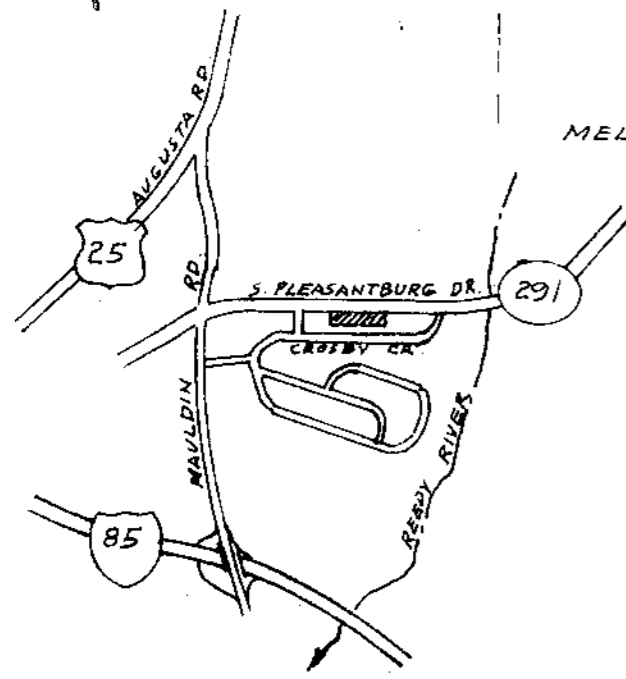


FILED
 GREENVILLE CO., S.C.
 OCT 11 4 12 PM '85
 DONNIE S. TANKERSLEY
 R.M.C.

SOUTH PLEASANTBURG DR. (S.C. HY. 291)

MICROFILMED

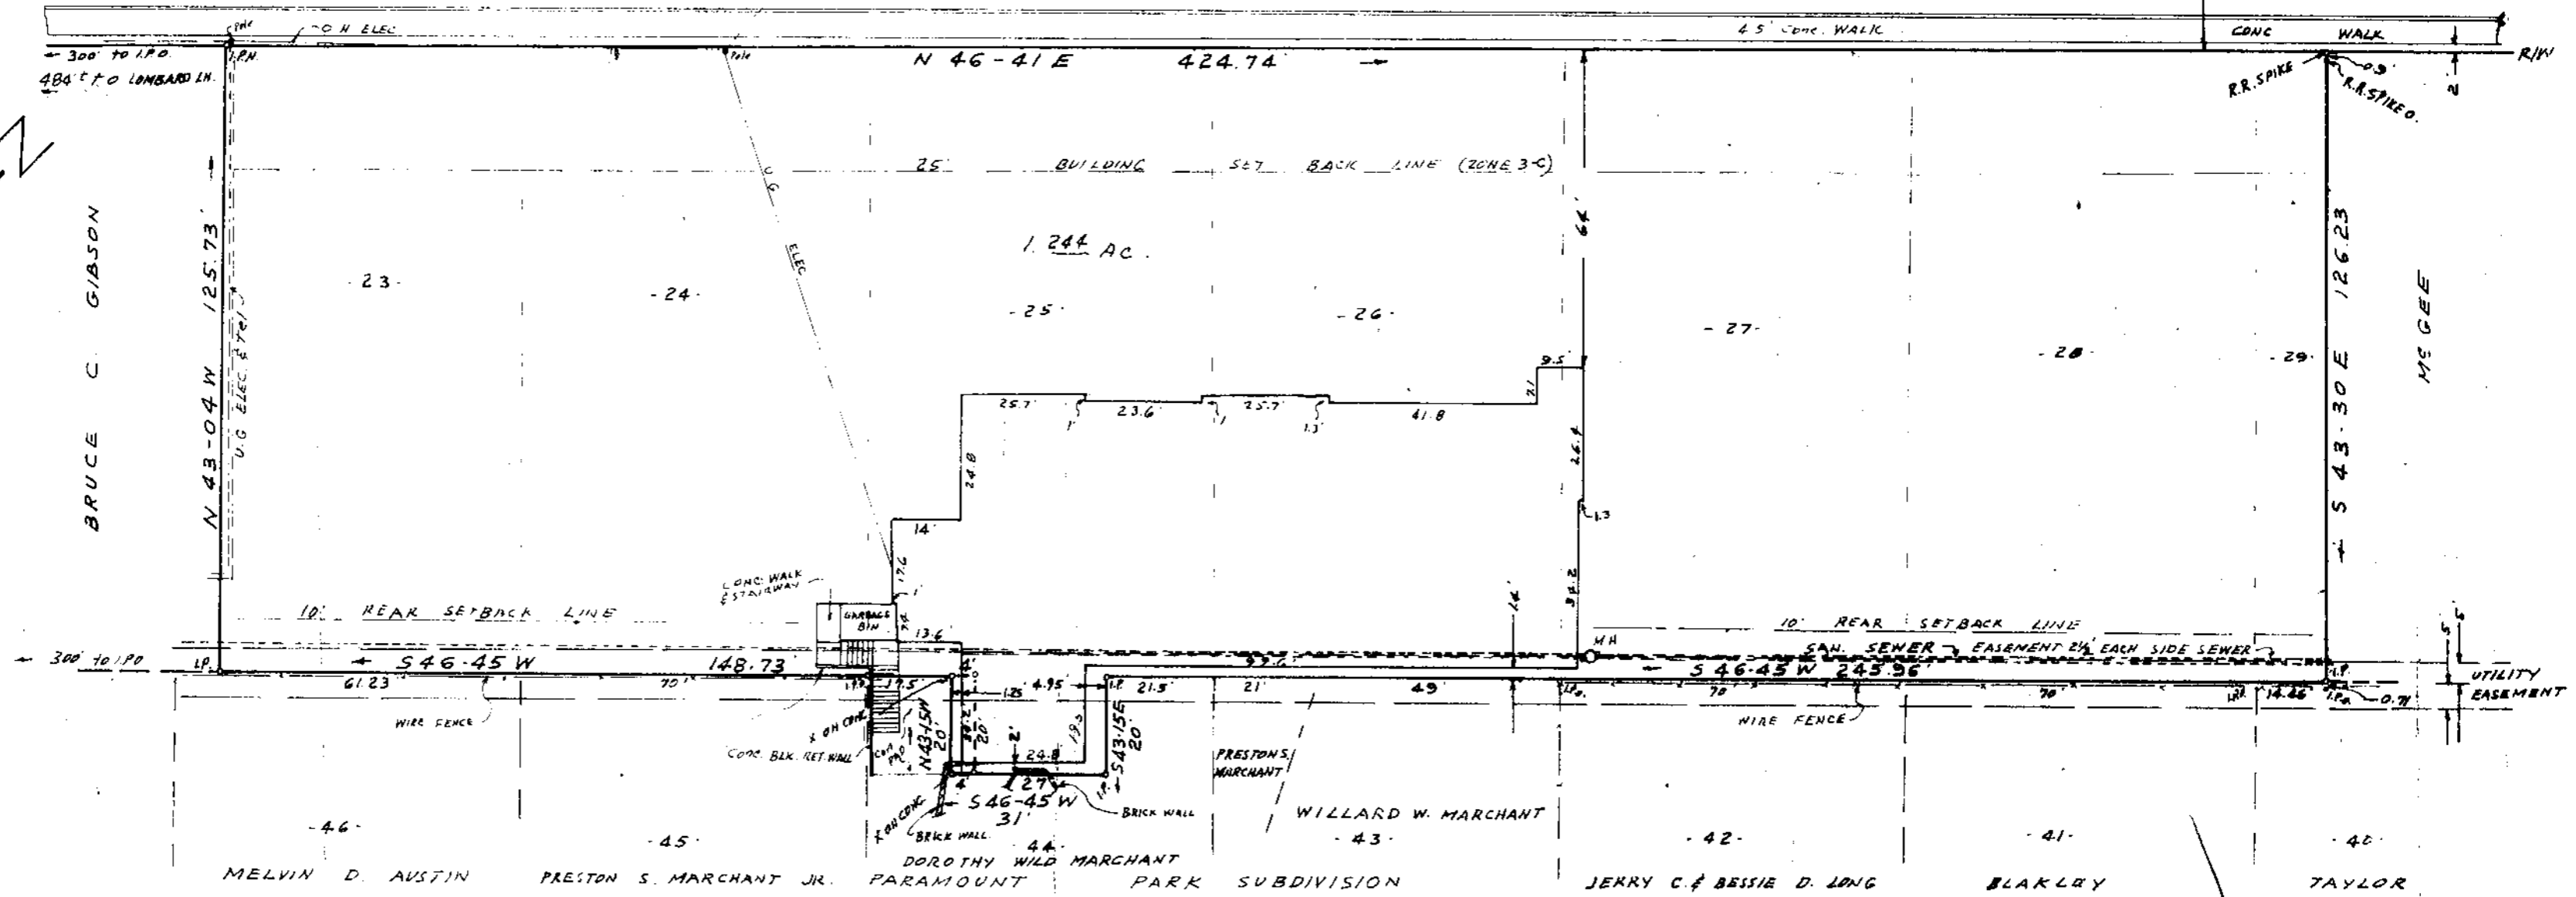

LOCATION MAP

I CERTIFY THAT THE RATIO OF PRECISION OF THE FIELD SURVEY IS 1/10,000 AND AREA WAS COMPUTED BY DMD METHOD.

REF. PORTION OF LOT 23 THROUGH 29 ON PLAT OF PARAMOUNT PARK, RECORDED IN PLAT BOOK W PAGE 57.

To all parties interested in title to premises surveyed, I certify that this is an accurate plat of a survey made by me OCT 3, 1985 that the survey was actually made on the ground as per record description and is correct, and that there are no encroachments either way except as noted hereon.

OCT 11 1985

12-A-25 12695
 SURVEY FOR
 CHRISTINE T. LOGAN
 GREENVILLE S.C.

SCALE 1" = 30'



C. O. Riddle - RLS #1347 Greenville, S.C.